


# T. 36 S., R. 11 E., W.M.

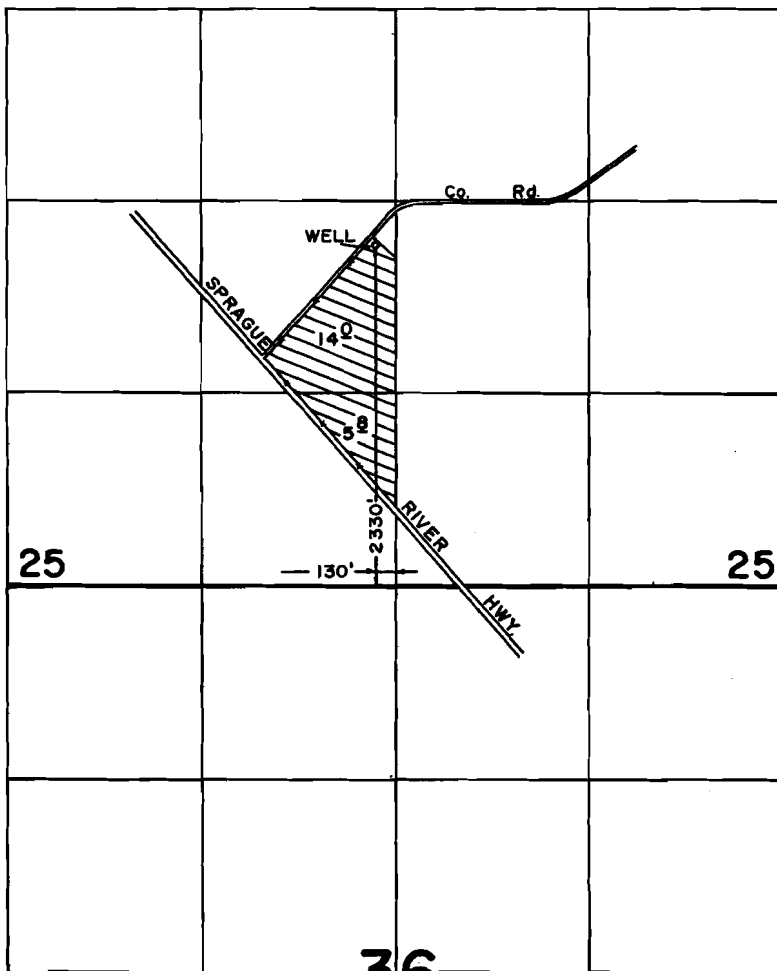

*Whiskey Creek Wells*

SCALE: 1" = 1320'

## FINAL PROOF SURVEY UNDER

Application No. G-9616.. Permit No. G-9533...  
IN NAME OF

.....VICKI L. MILLER.....

Surveyed SEPT. 26 1989, by B. W. BISHOP....