


T. 38 S., R. 11 1/2 E., W.M.

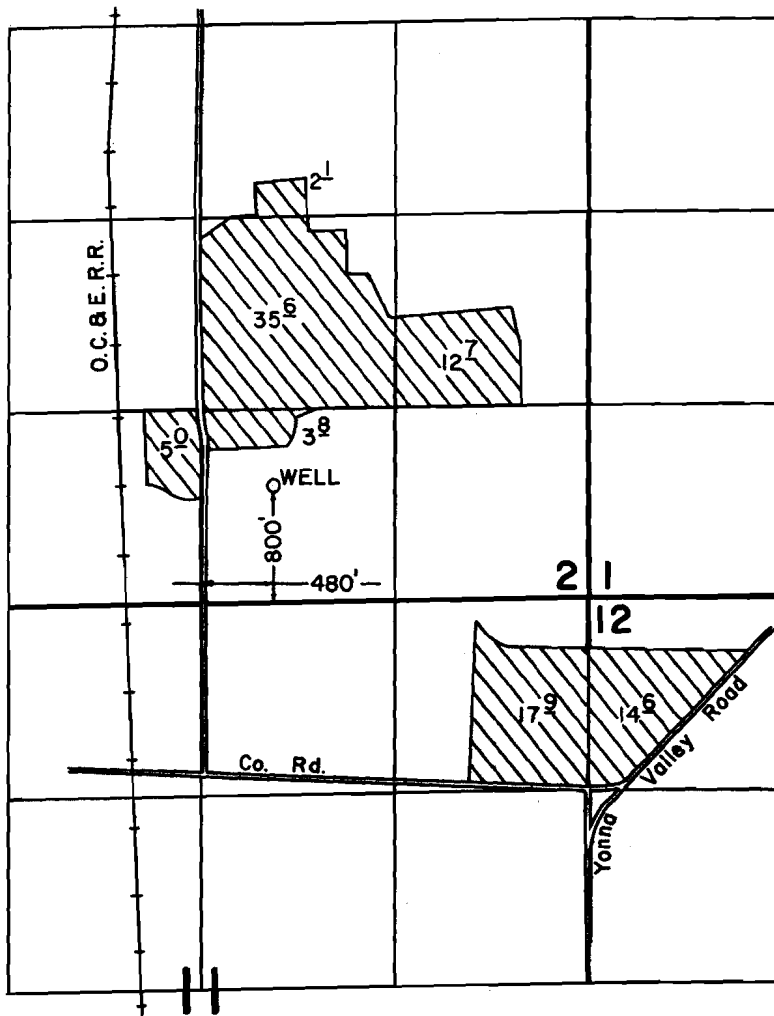

SCALE: 1" = 1320'

FINAL PROOF SURVEY UNDER

Application No. G-9738. Permit No. G-9031.....
IN NAME OF

.....ANGEL 7A RANCH, INC.....

Surveyed SEPT. 19. 1989., by B. W. BISHOP.....

1. Buck Crk. & Hanna Valley Wells