


T.27S., R.17E., W.M.

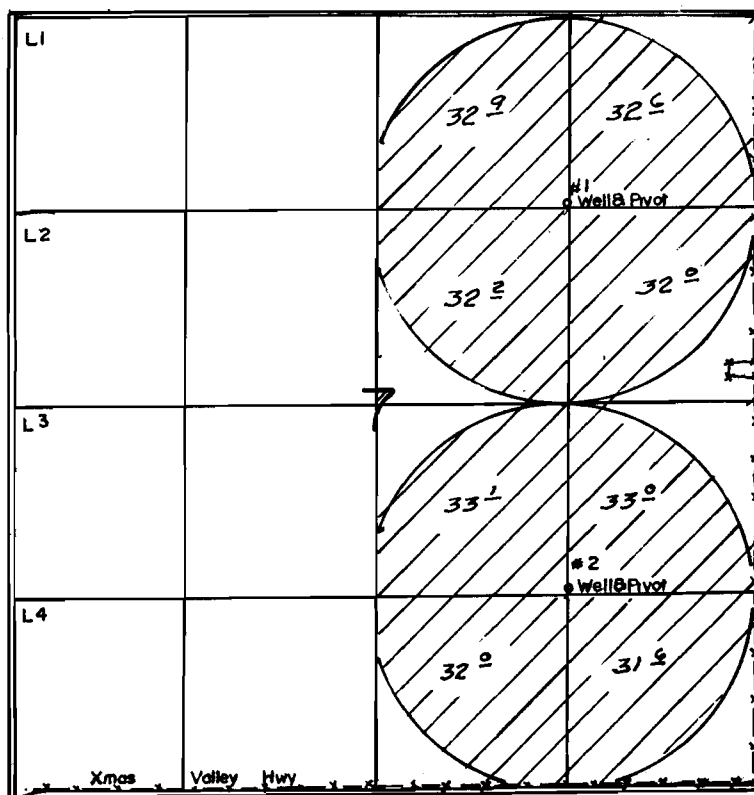

Well 1 Loc 1300'S & 1350'W From The NE Corner Of Section 7
 Well 2 Loc 1380'N & 1340'W From The SE Corner Of Section 7

SCALE: 1"=1320'

FINAL PROOF SURVEY

UNDER

Application No. G-2821.. Permit No. G-2066.....
 IN NAME OF

.....GOLDEN.....RULE.....FARMS.....

Surveyed JULY.27.. 1989., by B.W.BISHOP.....