


T. 31 S., R. 15 W., W. M.

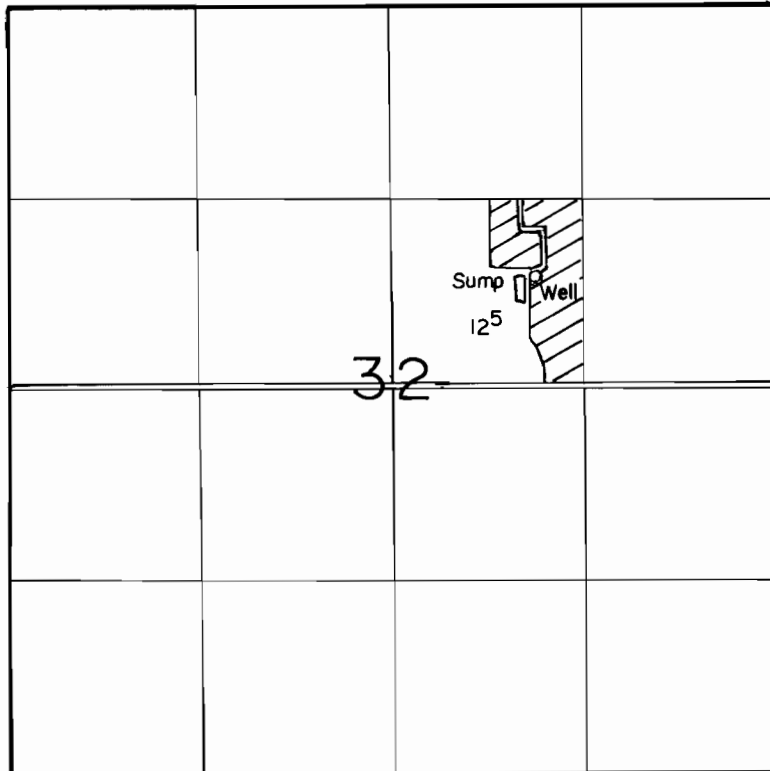

Well Loc 750' N & 1650' W, Sump Loc 750' N & 1750' W, Both From The E 1/4 Corner Of Section 32

SCALE: 1" = 1320'

**FINAL PROOF SURVEY**  
UNDER

Application No. G-10009. Permit No. G-9136.....  
IN NAME OF

**MARGARET RUNDBERG**

Surveyed AUG. 1, 1989, by B. S. JAMES.....