


29-9453

66018

T.6N., R.35E., W.M.

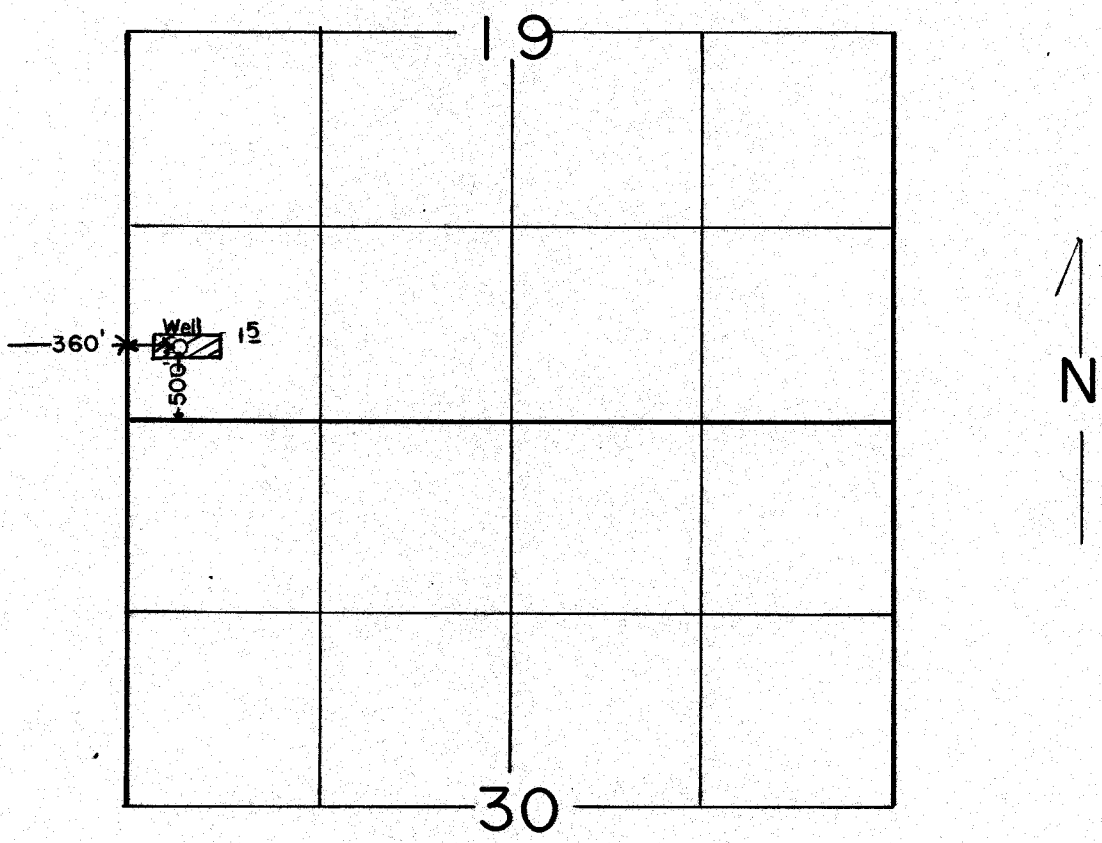

SCALE: 1"=1320'

FINAL PROOF SURVEY
UNDER

Application No. G-10230. Permit No. G-9453.....
IN NAME OF

...THEODORE...VAN VOORST.....

Surveyed SEPT...3..... 19.89., by J.M...SCHMORDE..