




# T. 39 & 40 S., R. 8 E., W.M.

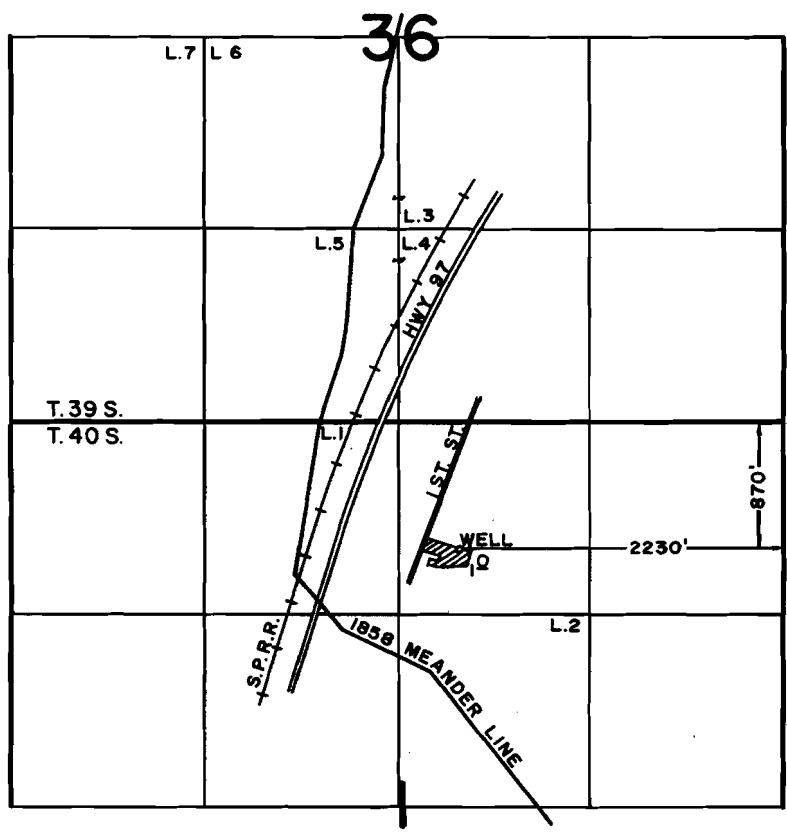

SCALE: 1" = 1320'

## FINAL PROOF SURVEY UNDER

Application No. G-10296 Permit No. G-9570.....  
IN NAME OF

**STEVE & FRAN GORHAM**

Surveyed JUNE 14, 1989, by B.W. BISHOP.....

