


T.28S., R.14W., W.M.

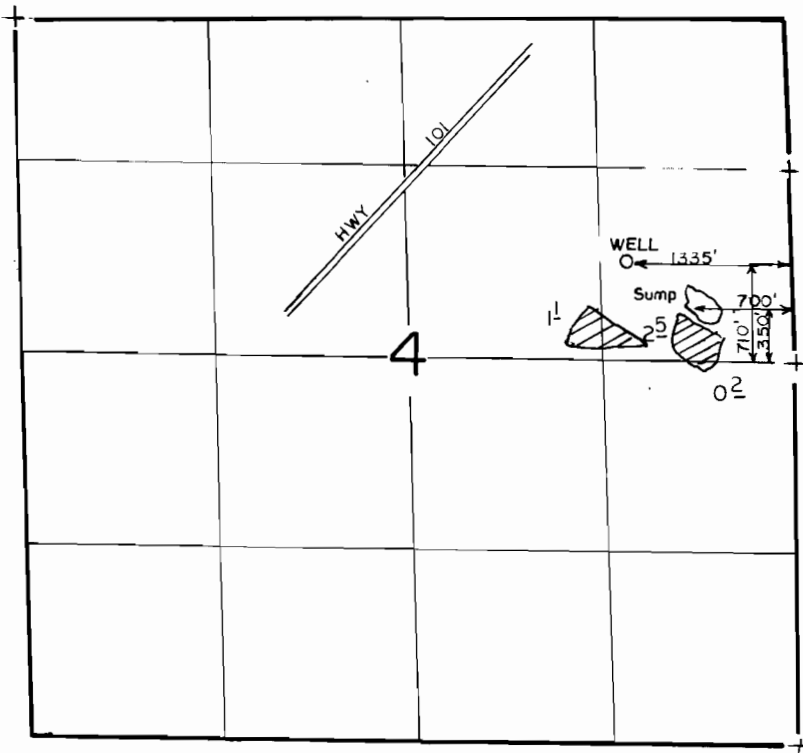

SCALE: 1"=1320'

FINAL PROOF SURVEY
UNDER

Application No. G-11254... Permit No. G-10368.....
IN NAME OF

.....**REX PIERCE**.....

Surveyed SEPT. 19... 1989., by B.S. JAMES.....