


# T. 40 S., R. 11 E., W.M.

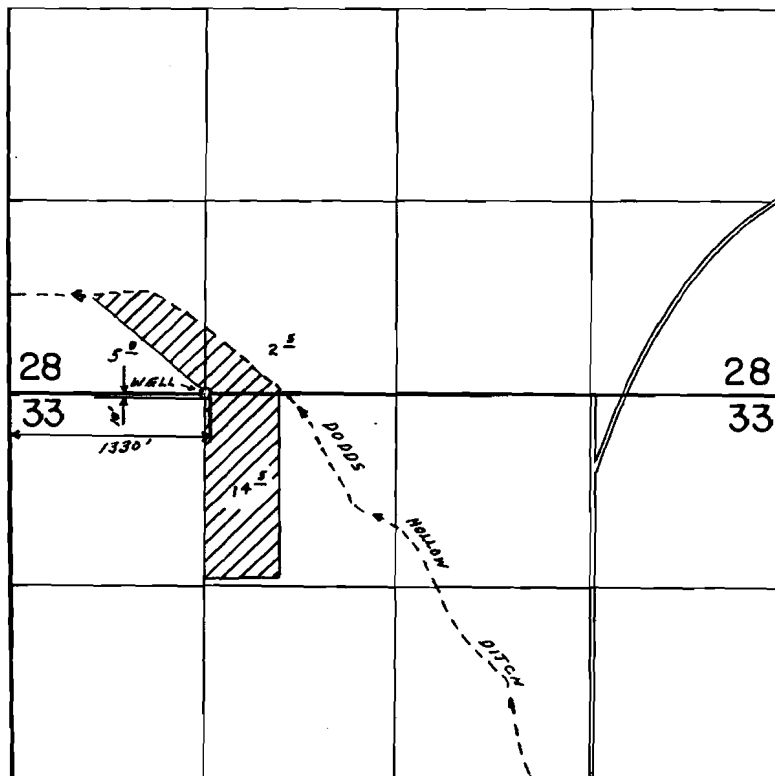

SCALE: 1" = 1320'

## FINAL PROOF SURVEY UNDER

Application No. G-11273 Permit No. G-10408..  
IN NAME OF

LYNN R. POPE

Surveyed AUG. 18, 1987, by V.L. CHURCH..

Short River Wells