


T. 6 N., R. 35 E., W. M.

SCALE 1"=1320'

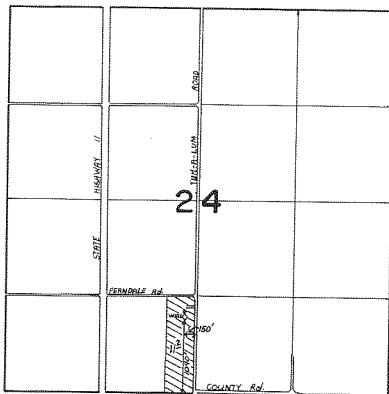

**FINAL PROOF SURVEY**  
UNDER

Application No. G-11287, Permit No. G-10443  
IN NAME OF

GAILORD G. NELSON & LILLIAN A. MADDUX

Surveyed JULY 15, 1926, by J. K. Switzer