


T. 4 S., R. 1 E., W. M.

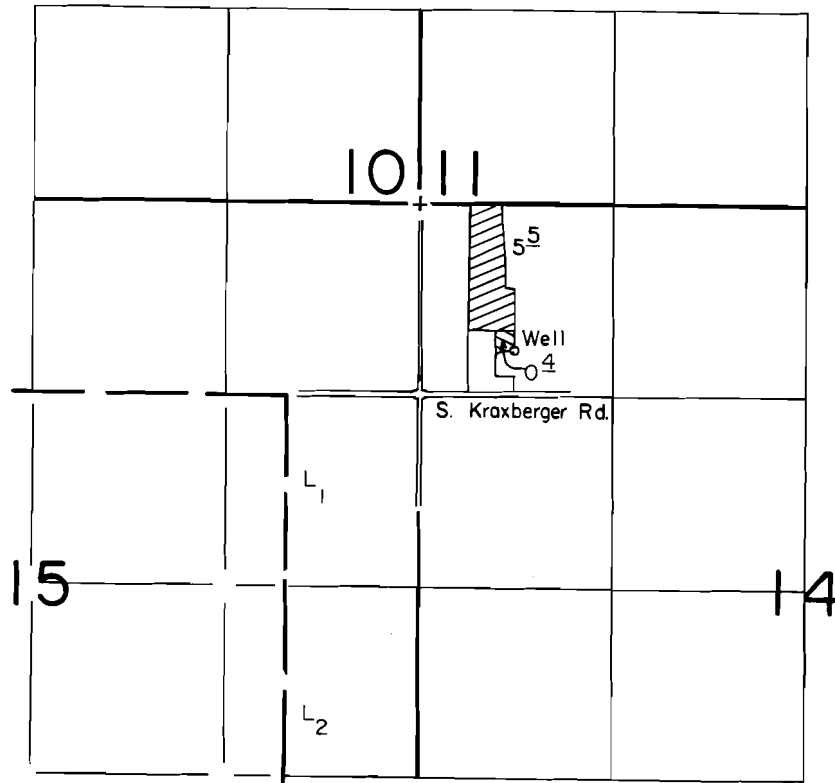

Well Loc. : 1000' S. & 650' E. from NW Cor. Sec. 14

Scale : 1" = 1320'

 Holding area &
Container Stock

 Irrigation &
Related Nursery Uses

FINAL PROOF SURVEY UNDER

Application No. G-11415.... Permit No. G-10531....
IN NAME OF

WILL LIGHTY

Surveyed Dec. 22, 1989, by T. Warren