



T. 33 S., R. 5 W., W.M.

B.C.

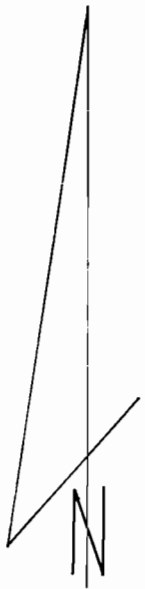

1" = 1320'

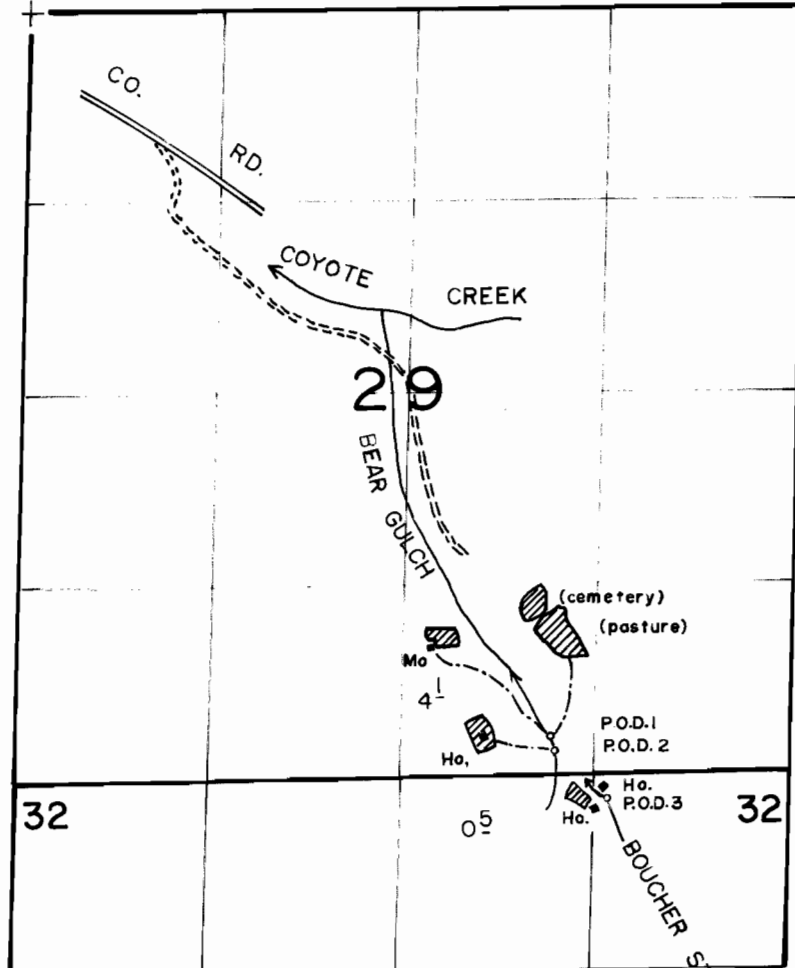

P.O.D. 1 - 5000' S. & 3530' E. FROM NW COR. SEC. 29

P.O.D. 2 - 5100' S. & 3550' E. FROM NW COR. SEC. 29

P.O.D. 3 - 5450' S. & 3700' E. FROM NW COR. SEC. 29

FINAL PROOF SURVEY UNDER

Application No. 50265 Permit No. 37961
IN NAME OF

LARRY G. BOUCHER

Surveyed NOV. 15, 1989, by B.S. JAMES