


T.10S., R.7W.,W.M.

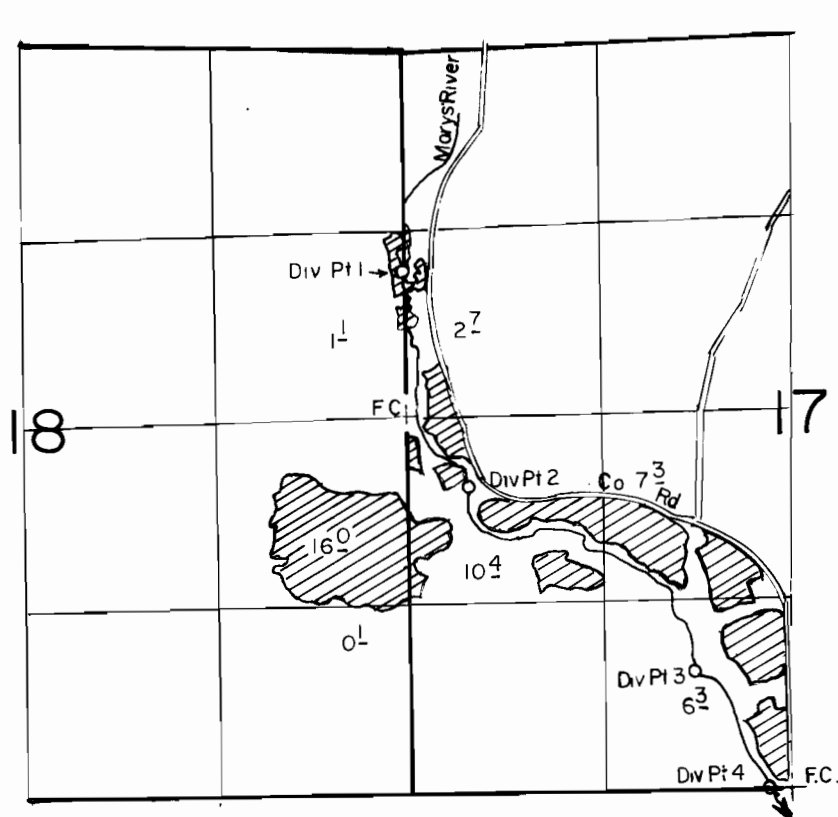

Div Pts Located, 1-1000'N&10'E, 2-480'S&400'E, Both From W1/4 Corner 3-
820'N&650'W, 4-20'N&150'W, Both From S1/4 Corner Of Section 17

SCALE: 1"=1320'

FINAL PROOF SURVEY UNDER

Application No. 51165..... Permit No. 38668.....
IN NAME OF

.....CARROLL F. POLAND.....

Surveyed OCT. 29. 1987., by J.M. WARREN.....