




T. 27 S., R. 12 & 13 W., W.M.

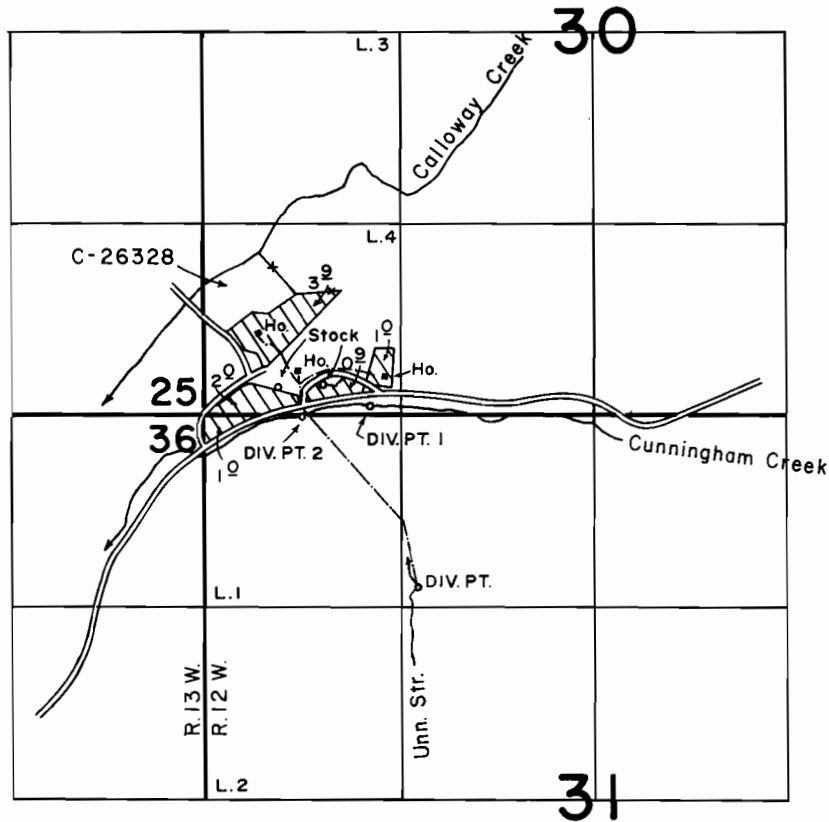

DIV. PTS. LOC.: Unn. Str. - 1190' S. & 1470' E.; Creek - 60' N. & 1140' E.,
 10' S. & 680' E., ALL FROM NW CORNER SECTION 31.

SCALE: 1" = 1320'

FINAL PROOF SURVEY UNDER

Application No. 53774 Permit No. 40381.....
 IN NAME OF

E. C. & PHYLLIS HAMILTON, VERRILL R. & VERA MCCURDY, ERNEST H. KREWSON

Surveyed JAN. 31... 1990, by B. S. JAMES.....

gc