


T. 35 S., R. 14 W., W. M.

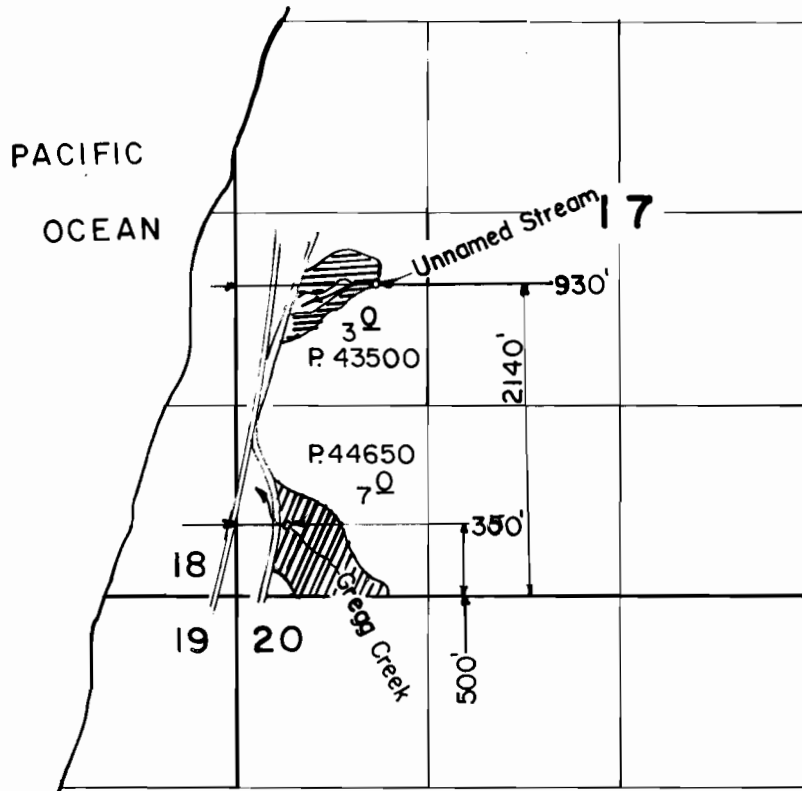

Scale: 1" = 1320'

FINAL PROOF SURVEY UNDER

57753 43500
 Application No. 59312... Permit No. 44650...
 IN NAME OF

..... JOHN L. WELSH

Surveyed JUL. 25. 1988, by B. S. JAMES.....