


T. 37 & 38 S., R. 6 W., W. M.

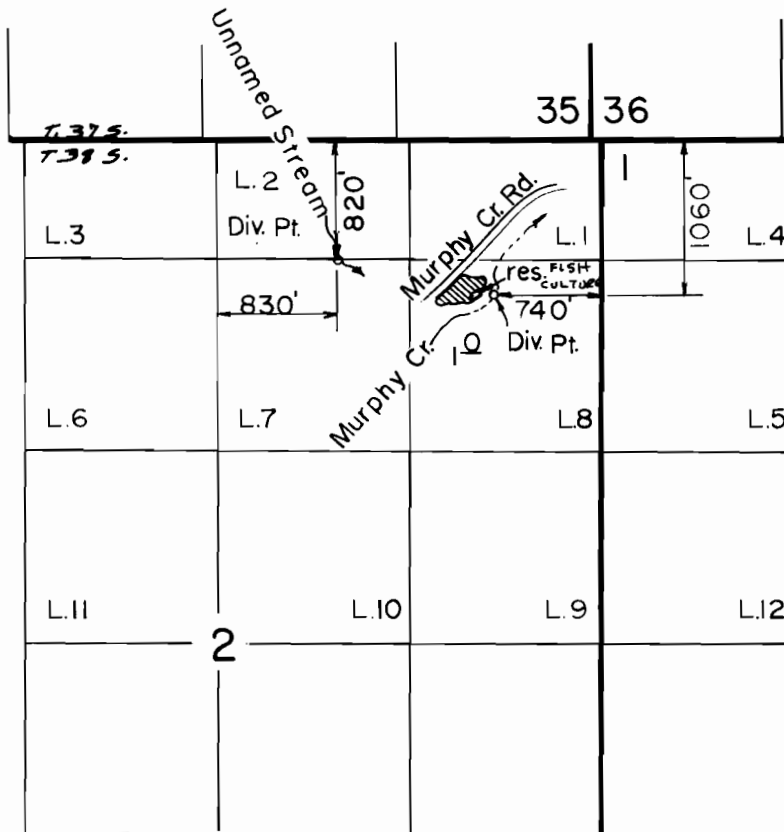

Scale: 1" = 1320'

### FINAL PROOF SURVEY

UNDER

R-64775

R-8653

64776

47522

Application No. 57893 Permit No. 43669

IN NAME OF

JOHN & CAROLINE BERKMAN

Surveyed MAY 24, 1988, by B. S. JAMES