90684

T. 37 & 38 S., R. 6 W., W. M.

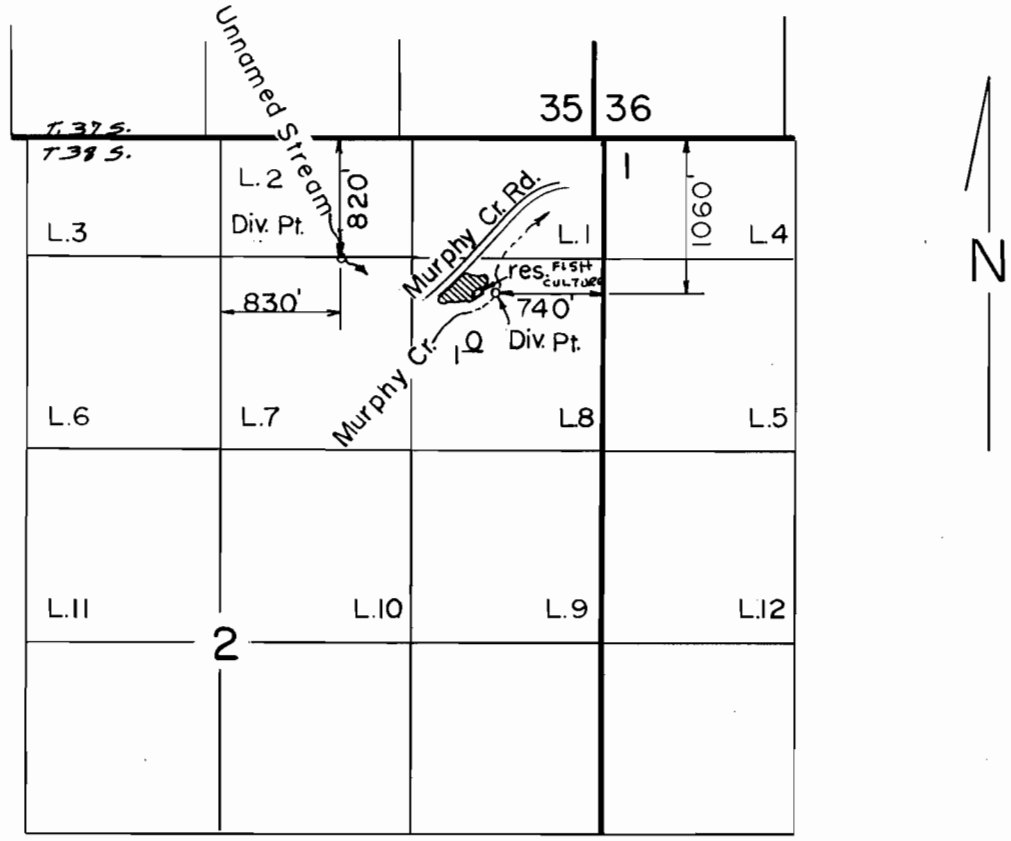

Scale: 1" = 1320'

FINAL PROOF SURVEY

UNDER

Application No. R-64775 64776 57893 Permit No. R-8653 47522 43669

IN NAME OF

JOHN & CAROLINE BERKMAN

Surveyed MAY 24 1988, by B. S. JAMES

41033-179-912 LMS