


T. 37 & 38 S., R. 6 W., W. M.

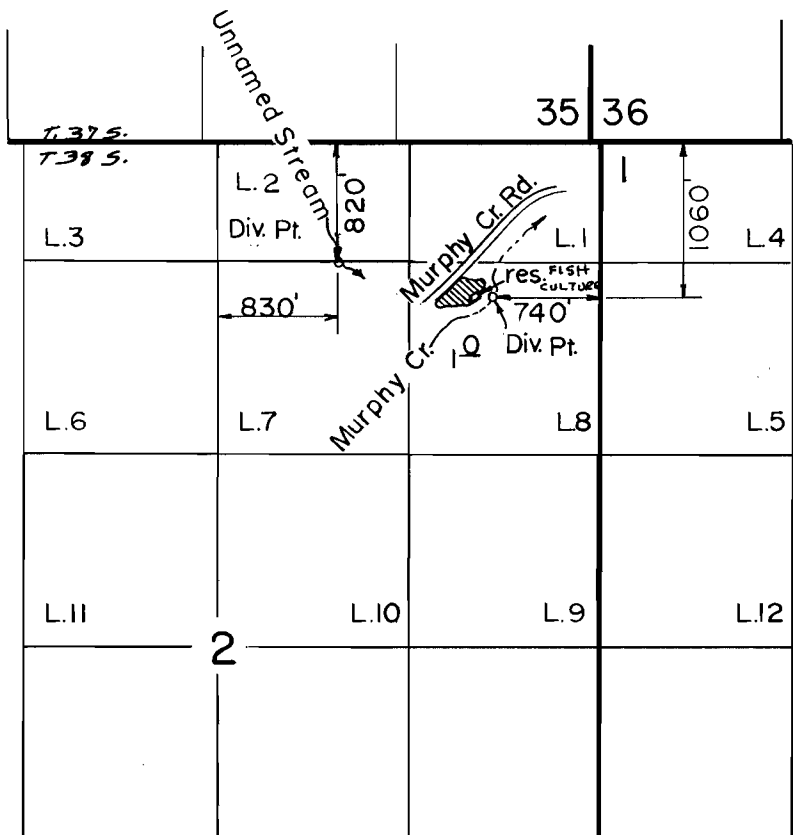

Scale: 1" = 1320'

FINAL PROOF SURVEY UNDER

R-64775 R-8653
 64776 47522
 Application No. 57893 Permit No. 43669
 IN NAME OF

JOHN & CAROLINE BERKMAN

Surveyed MAY 24 1988, by B. S. JAMES