



T.30S., R.14W., W. M.

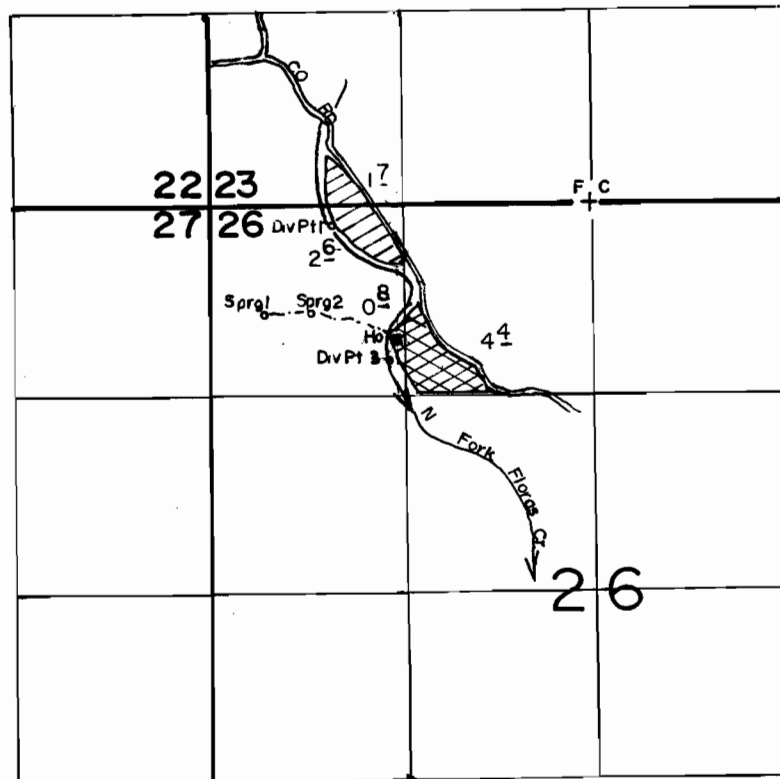

Div Pts Loc 1-150' S & 850' E, 3-1100' S & 1250' E, Springs Loc 1-770' S & 450' E,
2-740' S & 700' E, All From The NW Corner Of Section 26

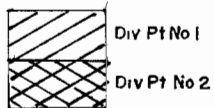

SCALE: 1"=1320'

FINAL PROOF SURVEY UNDER

Application No. 58845.. Permit No. 44768.....

IN NAME OF

RUBEN J. SAEZ

Surveyed JUNE 5.... 19.90., by B.S. JAMES.....