


# T. 35 S., R. 14 W., W. M.

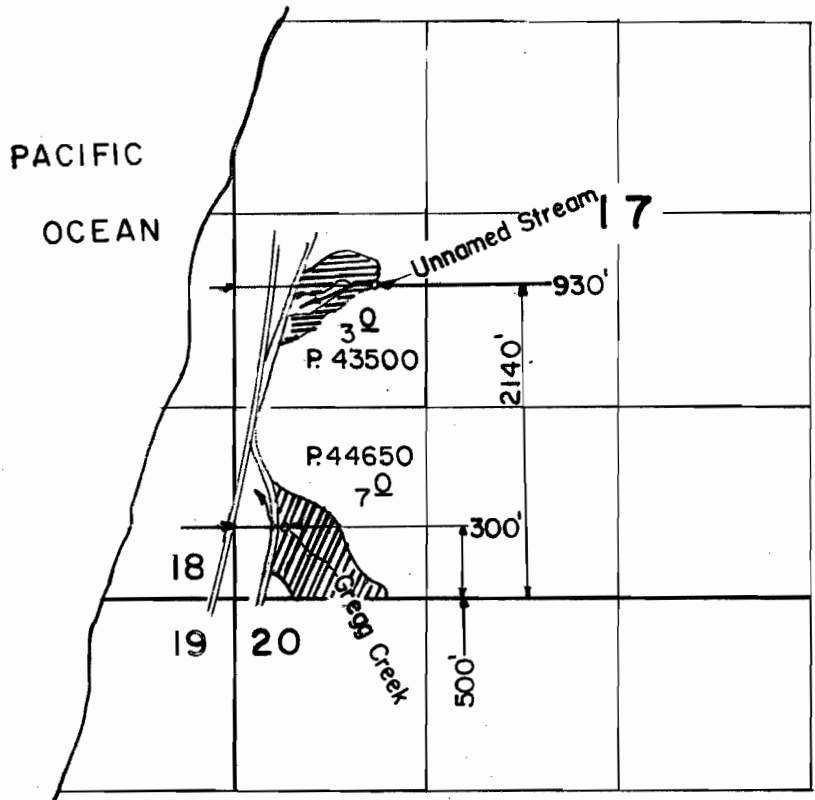

Scale: 1" = 1320'

## FINAL PROOF SURVEY UNDER

57753                      43500  
 Application No. 59312... Permit No. 44650...  
 IN NAME OF

..... JOHN L. WELSH .....

Surveyed JUL. 25. 19.88, by B. S. JAMES.....