



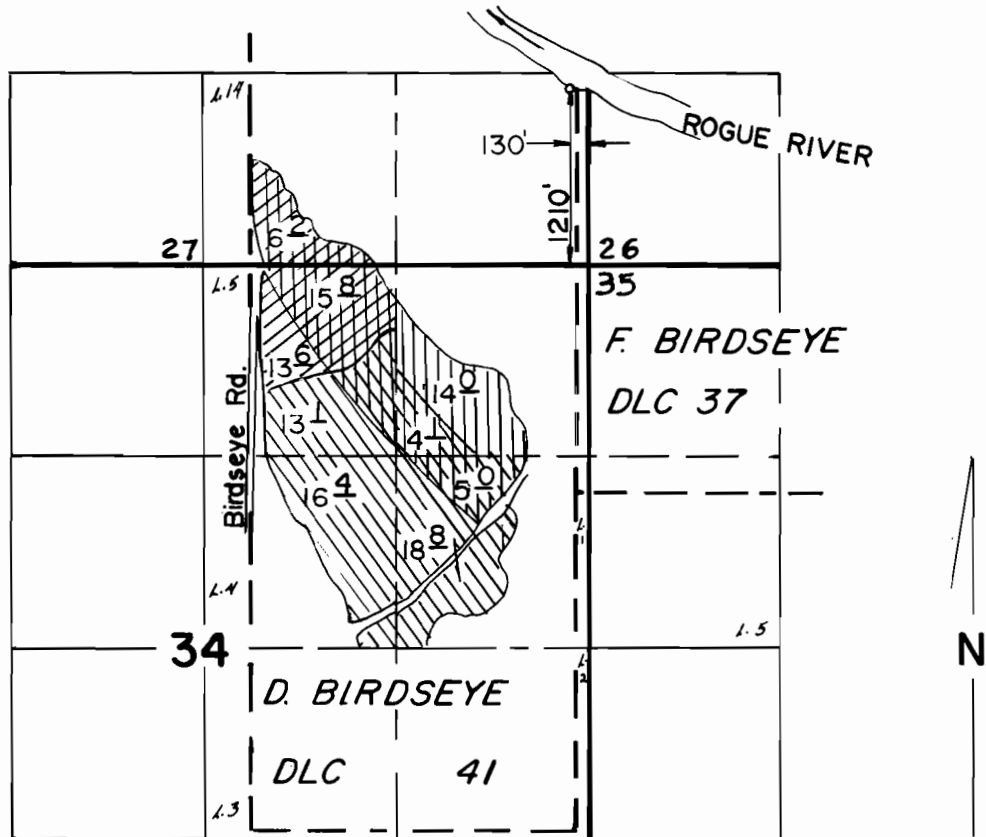

# T. 36 S., R. 4 W., W. M.

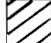

Scale: 1" = 1320'

-  P. 44982 primary
-  P. 44982 supplemental
-  P. 45887 supplemental

## FINAL PROOF SURVEY UNDER

59686                      44982  
 Application No. 61903 Permit No. 45887.....  
 IN NAME OF

.....GLENN C. BIRDSEYE.....

Surveyed AUG. 30 1988, by B. S. JAMES.....