


T.6S., R.39E., W.M.

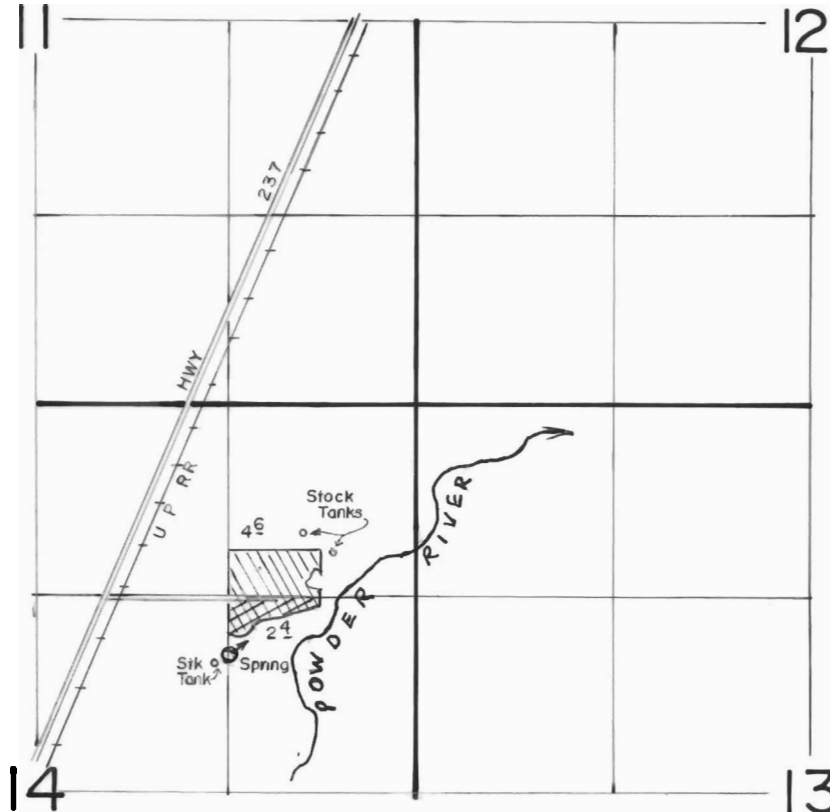

SPRING LOC 1700'S & 1300'E FROM N1/4 CORNER OF SECTION 14



PRIMARY



SUPPLEMENTAL

SCALE: 1" = 1320'

FINAL PROOF SURVEY UNDER

Application No. 61092... Permit No. 45716.....
IN NAME OF

.....DON.....DODSON.....

Surveyed MAR.23. 19.89., by .K.K.KEMP.....