


T. 39 S., R. 5 W., W. M.

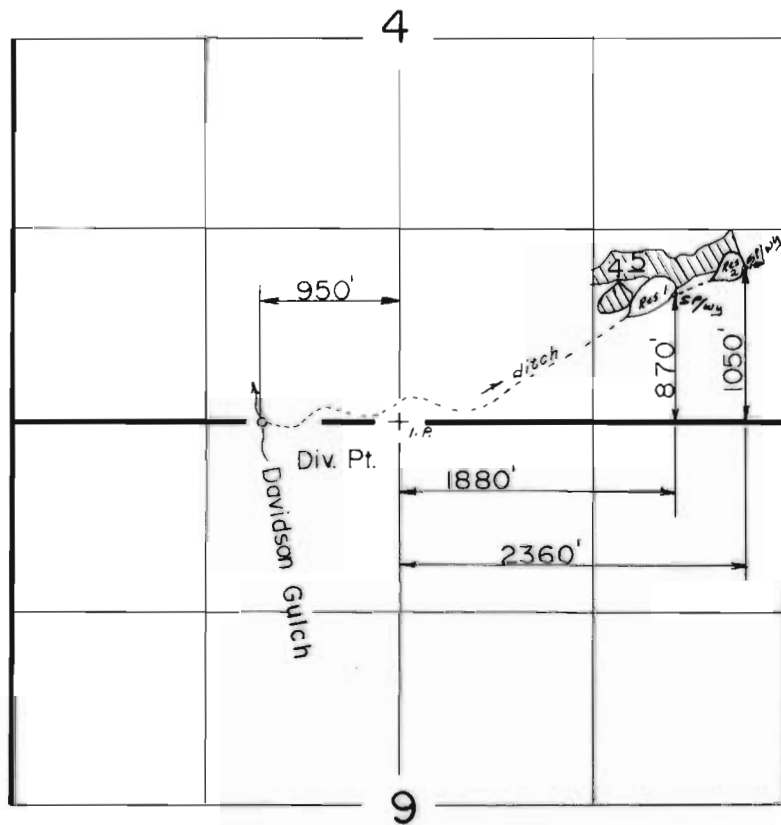

Scale: 1" = 1320'

FINAL PROOF SURVEY

UNDER

R-61295 R-8394
Application No. 61279 Permit No. 46615....
IN NAME OF

.....ELIZABETH ANNE CLAY.....

Surveyed JUL 7 19.88, by B. S. JAMES...