


T. 32 S., R. 3 W., W. M.

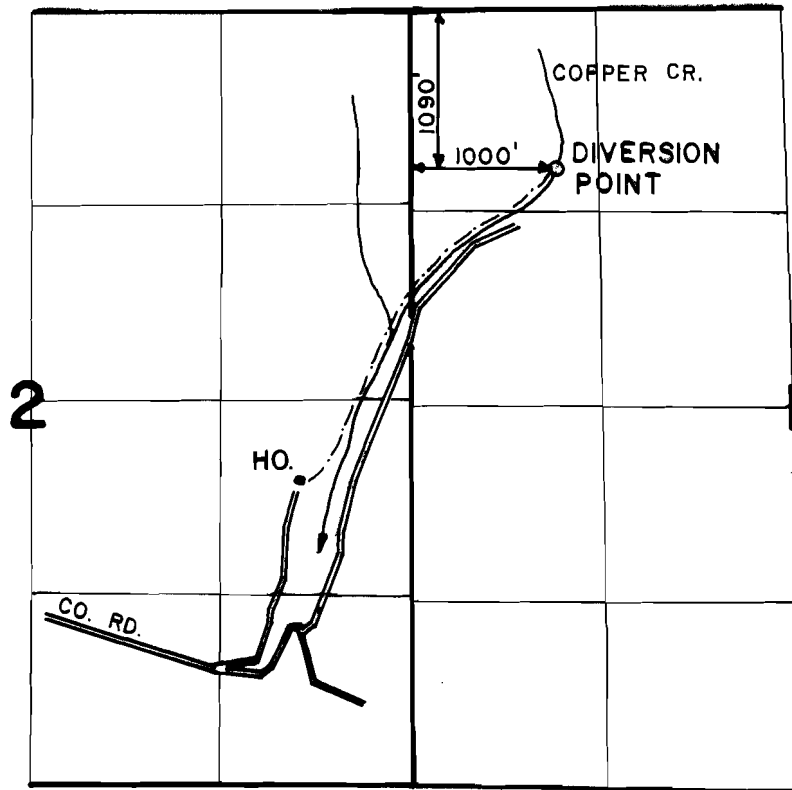

SCALE: 4" = 1 MILE

FINAL PROOF SURVEY
UNDER

Application No. 61526 Permit No. 45693
IN NAME OF

DIANA W. ADLER AND CHRISTOPHER D. HOUSEMAN

Surveyed AUG. 10. 1988. by J. M. SCHMORDE.