


T. 4 S., R. 2 E., W.M.

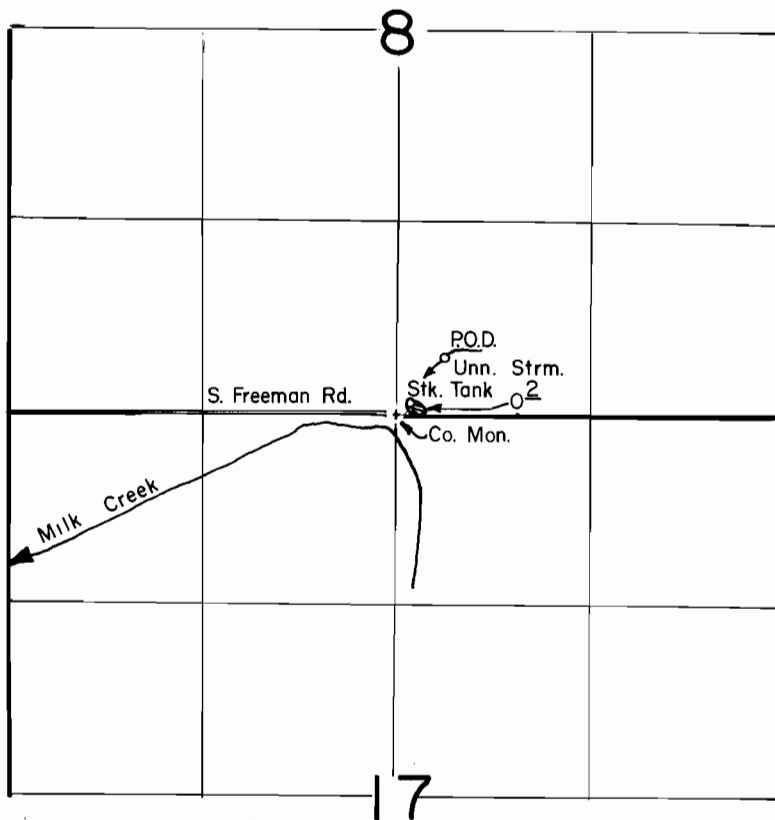

P.O.D. Loc.: 400' N. & 330' E. from S. 1/4 Cor. Sec. 8.

Scale: 1" = 1320'

FINAL PROOF SURVEY UNDER

Application No. 61885 Permit No. 46256
IN NAME OF

MARK FRANK MADISON

Surveyed JULY 25, 1989, by R. KLASSEN