




T. 13 S., R. 16 & 17 E., W.M.

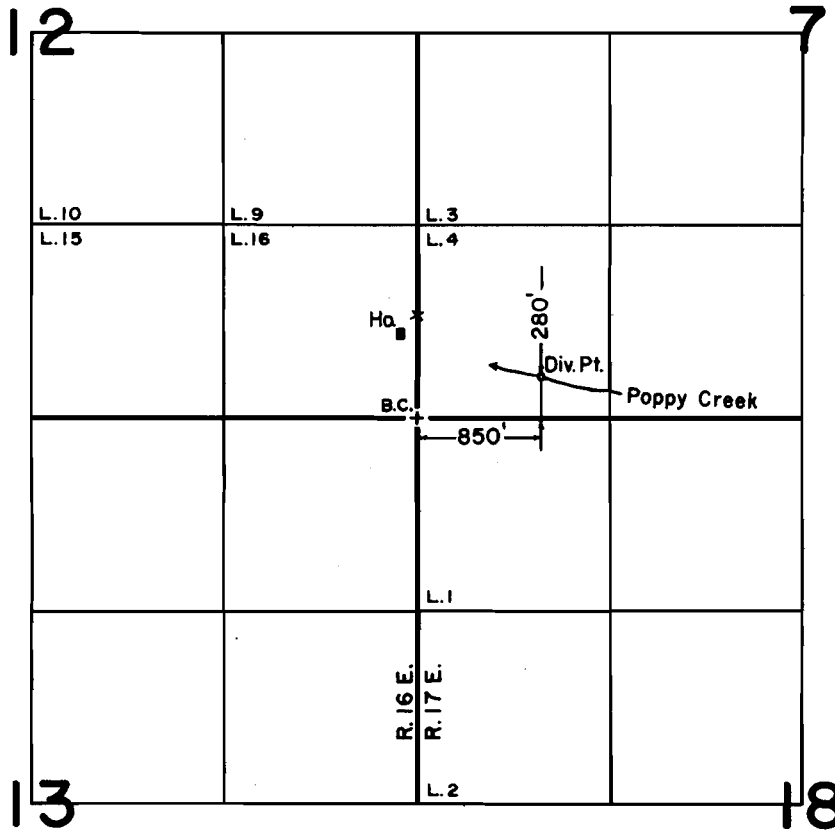

SCALE: 1" = 1320'

FINAL PROOF SURVEY UNDER

Application No. 61956... Permit No. 45975...
IN NAME OF

RICK STEBER

Surveyed DEC. 27. 1989., by B. W. BISHOP....

Cert. # 66044

Rec'd 7-16-91 WPA#11