


T. 12 S., R. 9 W., W.M.

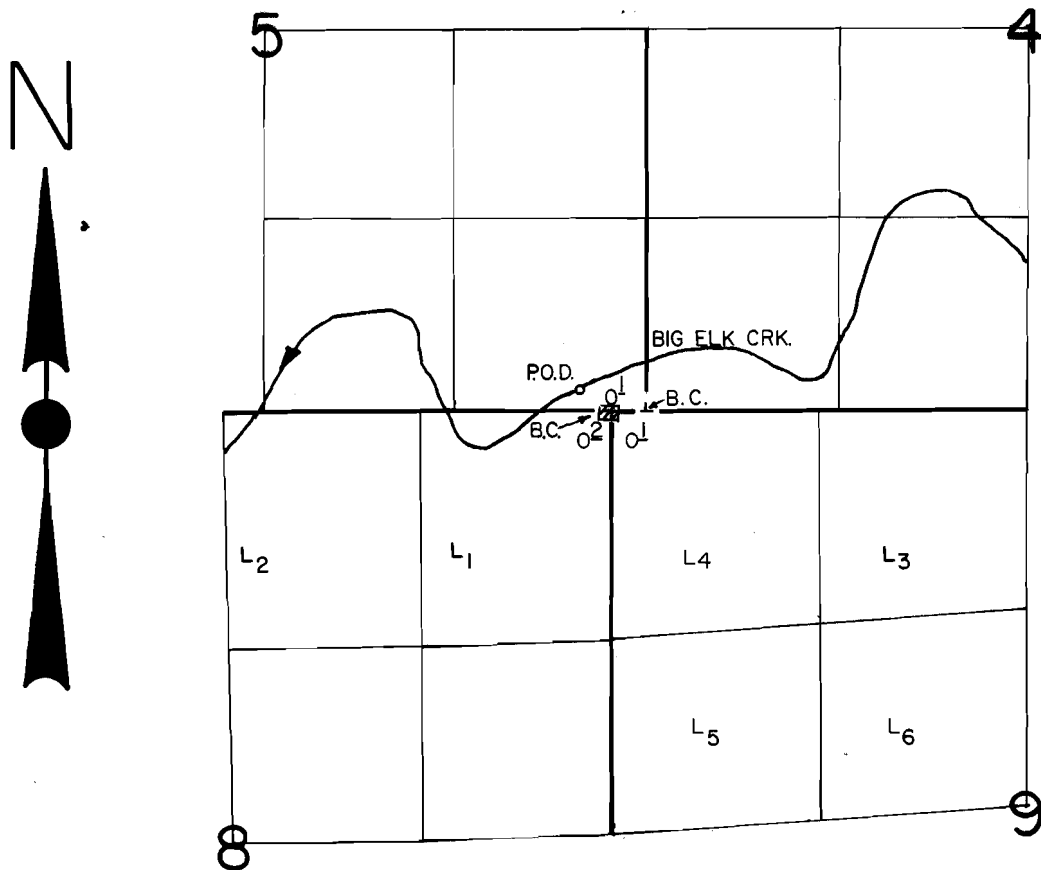

P.O.D. Loc. : 150' N. & 450' W. from SE Cor. Sec. 5.

Scale: 1" = 1320'

FINAL PROOF SURVEY UNDER

Application No. 61976... Permit No. 46306.....
IN NAME OF

DONNA FRANK & KEN RISKIN

Surveyed Sept. 20, 1989, by R. KLASSEN.....