




T. 33 S., R. 1 E., W.M.

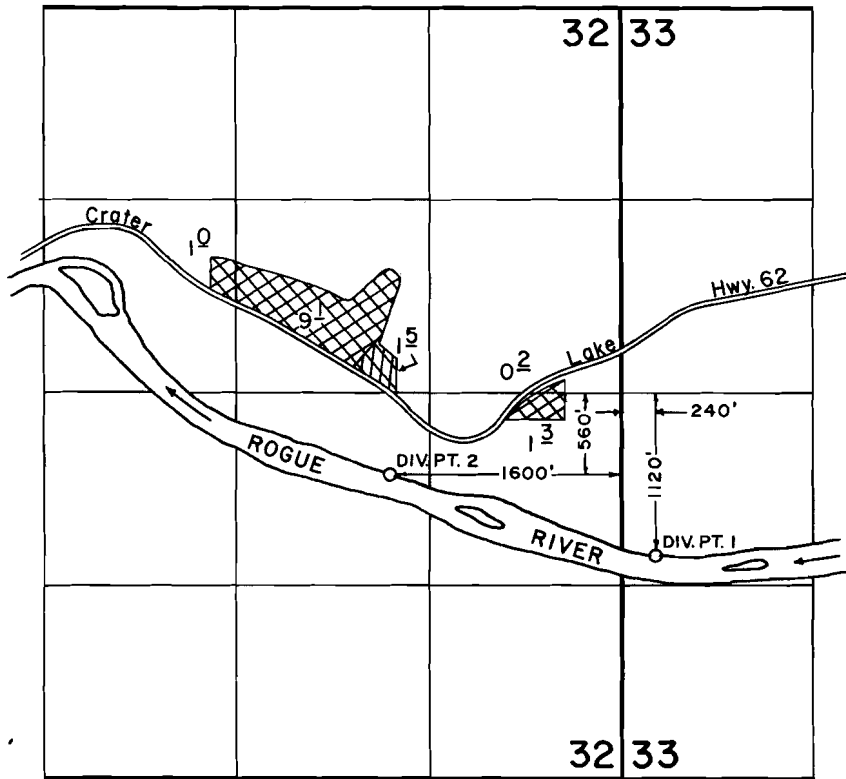

SCALE: 1" = 1320'

### FINAL PROOF SURVEY

UNDER

TRANSFER NO. 3508

55107

41329

Application No. 62197... Permit No. 46390.....

IN NAME OF

**GEORGE W. & BARBARA P. PEARSON & MARTHA P. BROOKS**

Surveyed JULY 6, 1989, by B.S. JAMES.....

	Primary		Suppl.
	Suppl.		