


T.34S., R.6W., W.M.

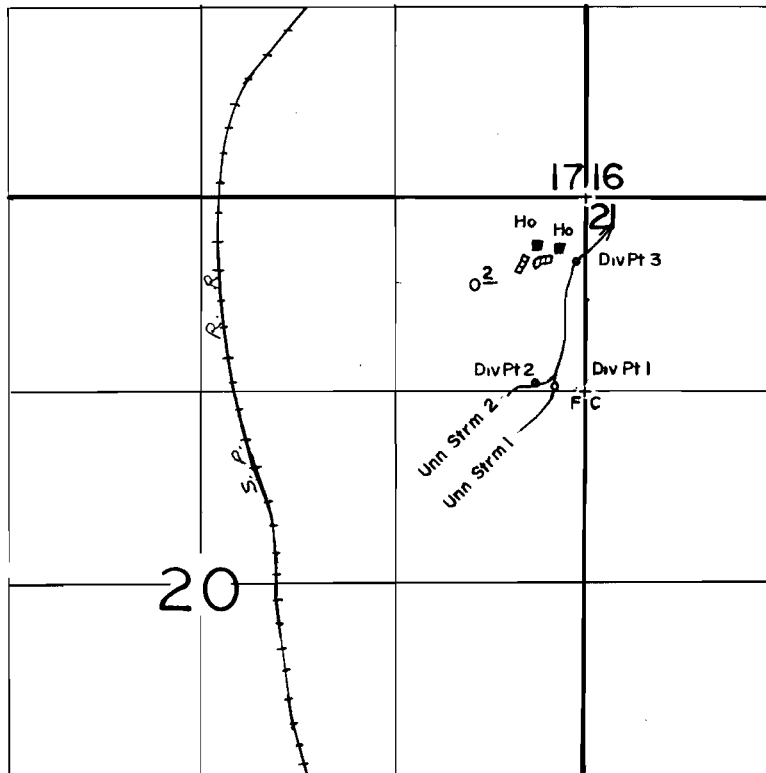

DIV. PTS. LOCATED- 1, 1300'S. & 200'W.- 2, 1290'S. & 330'W.- 3, 450'S. & 50' W
ALL FROM THE N.E. CORNER OF SECTION 20

SCALE: 1"=1320'

FINAL PROOF SURVEY
UNDER

Application No. 62748. Permit No. 47166.....
IN NAME OF

.....BONNIE.....J.....BAKER.....

Surveyed JUNE..13.. 1989., by B.S..JAMES.....