
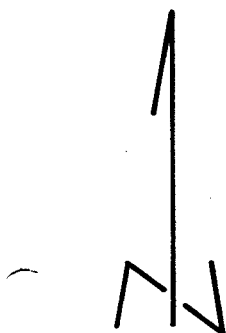


T. 6S., R. 20E., W. M.

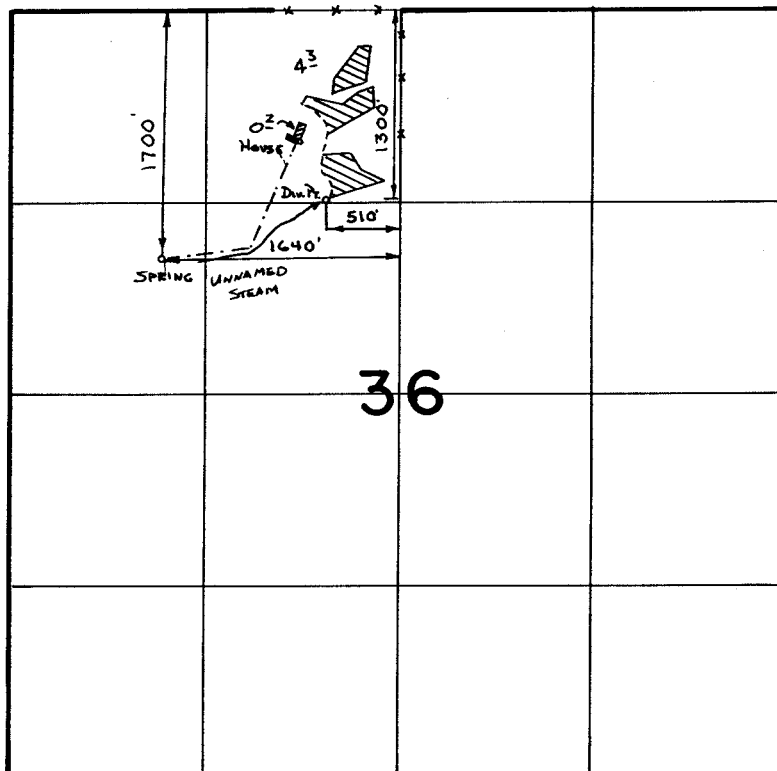

SCALE 1" = 1320'

FINAL PROOF SURVEY
UNDER

Application No. 62909 Permit No. 47029
IN NAME OF

JAMES L. HUMPHREY

Surveyed 5-13 1987., by V.L. Church