


T. 8 S., R. 47 E., W.M.

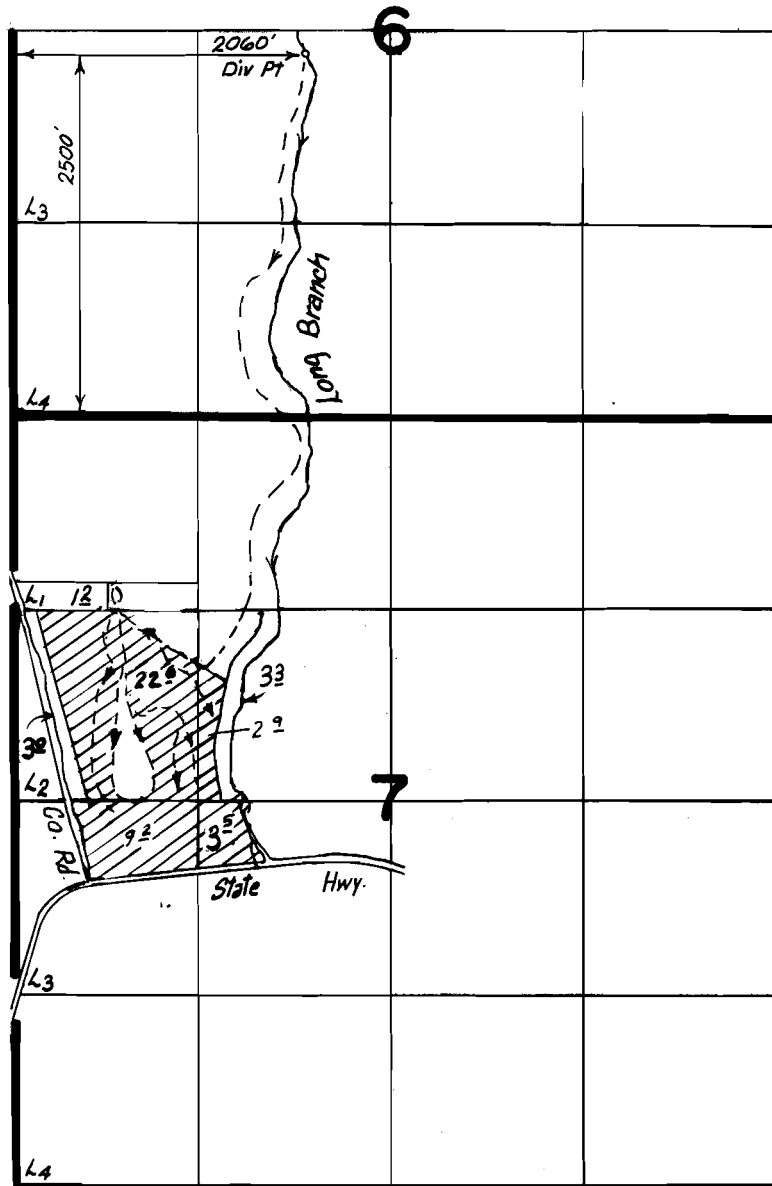

Scale: 1" = 1320'

FINAL PROOF SURVEY UNDER

Application No. 62987 Permit No. 47045
IN NAME OF

JAMES JONTHON HENDRIX

Surveyed 10-6 1988, by K. Kemp