


T. 13 S., R. 11 W., W. M.

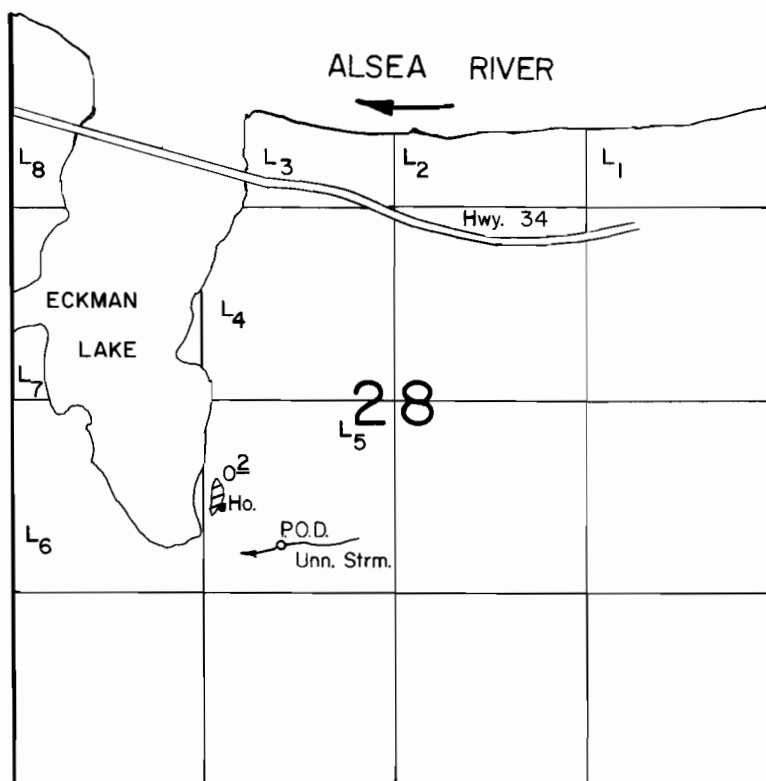

P.O.D. Loc.: 1000' S. & 780' W. from C-1/4 Cor. Sec. 28.

Scale: 1" = 1320'

FINAL PROOF SURVEY UNDER

Application No. 63406 Permit No. 47251

IN NAME OF

NEPTUNE TERRACE, INC.

Surveyed Nov. 15 1989, by J. Warren