


P-47182
C-66051

T. 15 S., R. 32 E., W.M.

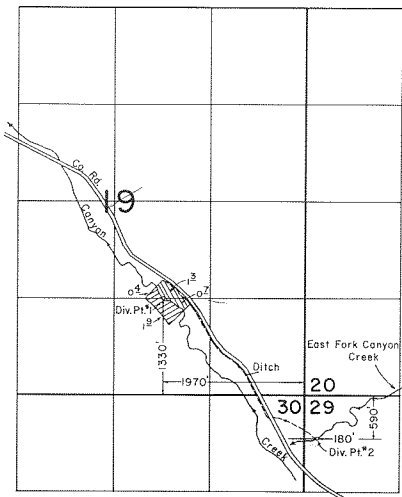

SCALE: 1" = 1320'

FINAL PROOF SURVEY
UNDER

Application No. 64509... Permit No. 47182...
IN NAME OF

 DIV. PT. #1
 DIV. PT. #2

..... **DON MEACHAM**

Surveyed JUNE 17, 1988, by V. L. CHURCH.....