

S.W. COR. DEED BK.754 PG.282 POINT OF BEGINNING

FOUND 5/8" I. R.

SET ON ROD

SEE DETAIL

5hp Submersible pump 1 1/2 hp " " "

Pump house WATER TANK

N-84°59'44"-E 322.83'

5-00°19'28"-W 90.00'

0.54 AC


291.09'

FROM HERB FRANK TO BILL KENNEY

WEST 60.00'

NORTH LINE OF HENRY HICKLIN D. L. C. #42

Diversion point located 50.52 FT north and 146.0 FT west from the SW corner of the NE 1/4 NE 1/4 Sec 18

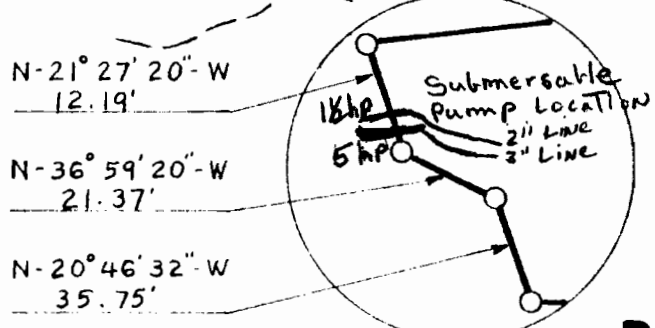

REGISTERED PROFESSIONAL LAND SURVEYOR

William L. McMonagle

OREGON

JULY 14, 1987

WILLIAM L. MCMONAGLE

P. O. B.

RECEIVED

FEB 10 1983

W. L. MCMONAGLE, ASST.

WATER RESOURCES DEPT.

SALEM, OREGON

TIGARD ORE. PH. 509-3453

RECORD OF SURVEY

FOR MR. BILL KENNEY

IN N.W. & N.E. 1/4 SEC. 18, T-2S

WASHINGTON COUNTY, ORE.

DATE: 5-18-81

SCALE: 1" = 200'

JOB NO. 81-11-8 (SEE HERB F)

BASIS OF BEARINGS: C. S. #15, 16

Application No. 64838

Permit No. 47550

NW & NE 1/4 Sec 18 T-2S R-1w W.M.