


T.3S., R.1E., W.M.

Sec. 14

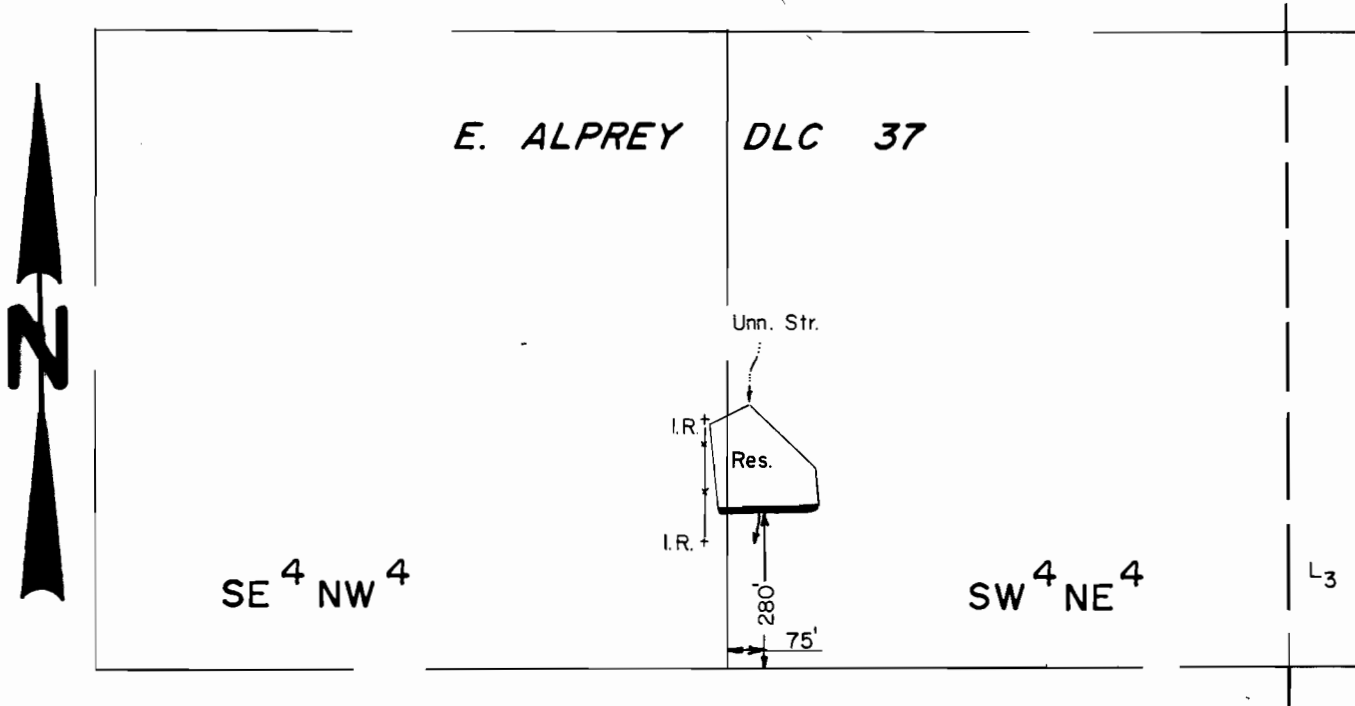

Scale: 1" = 400'

FINAL PROOF SURVEY UNDER

Application No. R-65272 Permit No. R-8896
IN NAME OF

DR. JOHN URBAN

Surveyed JULY 23, 1986, by T. Warren

PTS - 1986-C
TMW - 2/10/87