


T.1S., R.38E., W.M.

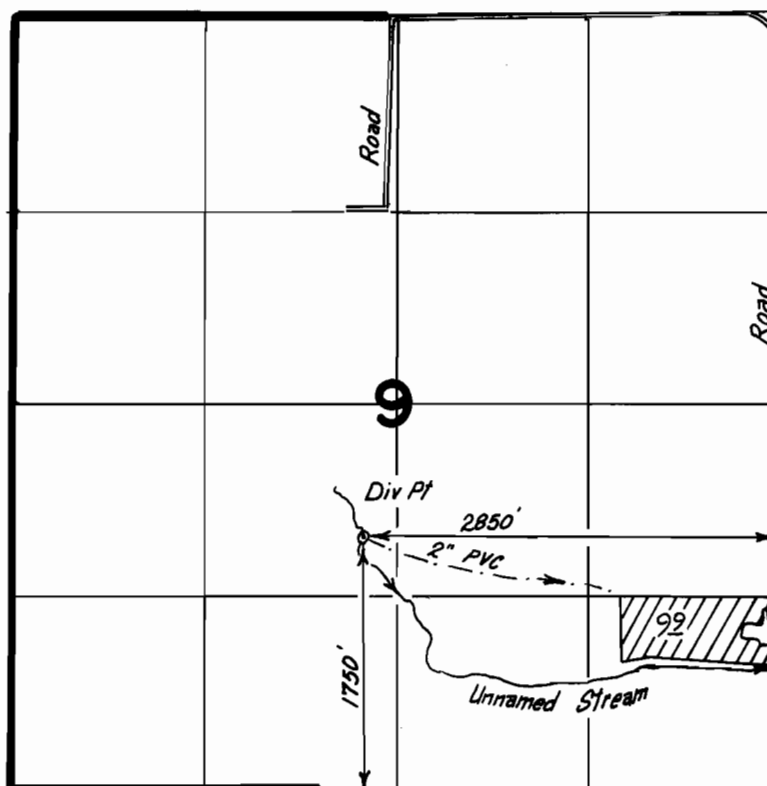

FINAL PROOF SURVEY
UNDER

Scale: 1" = 1320'

Application No. **65336** Permit No. **47939**
IN NAME OF

HARVEY J. & MARSHA K. MORGAN

Surveyed **5-3** 19**88**, by **Vern Church**