

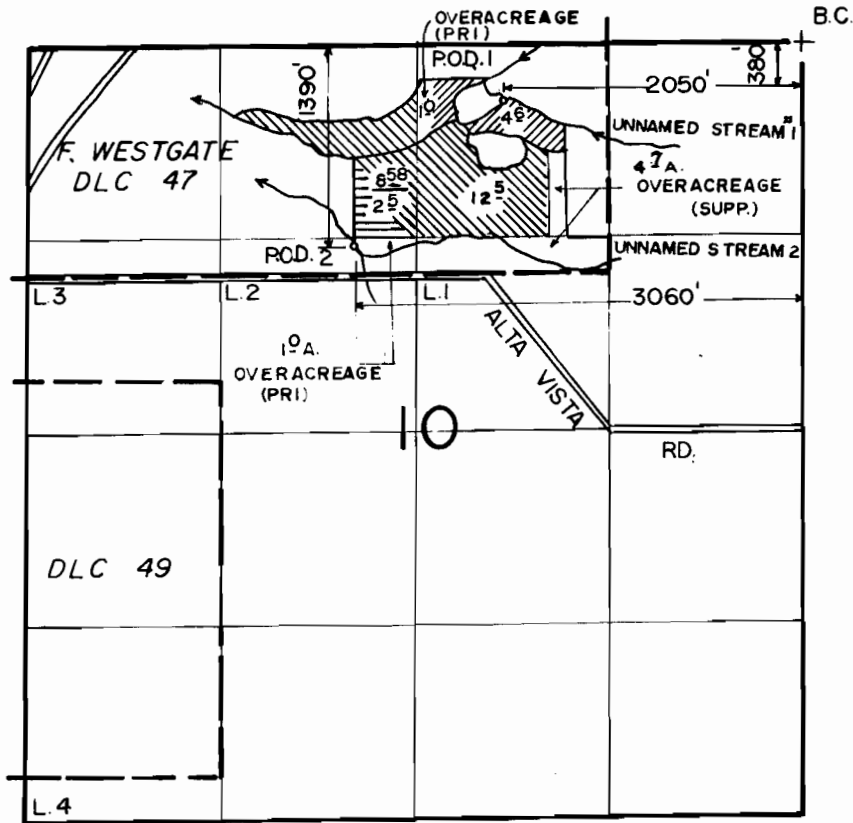
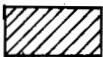
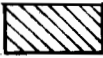


T. 36 S., R. 1 W., W.M.

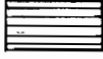

-  PRIMARY
-  SUPPLEMENTAL CERT. # 20730 PRIOR. 3-19-47
-  SUPPLEMENTAL CERT. # 15781 PRIOR. 9-19-44

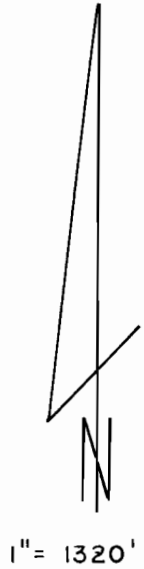

FINAL PROOF SURVEY UNDER

Application No. 66957 Permit No. 48316
IN NAME OF

..... STRAUS RANCHES

Surveyed OCT. 25 1989, by B.S. JAMES.....