


# T12S, R11W, WM

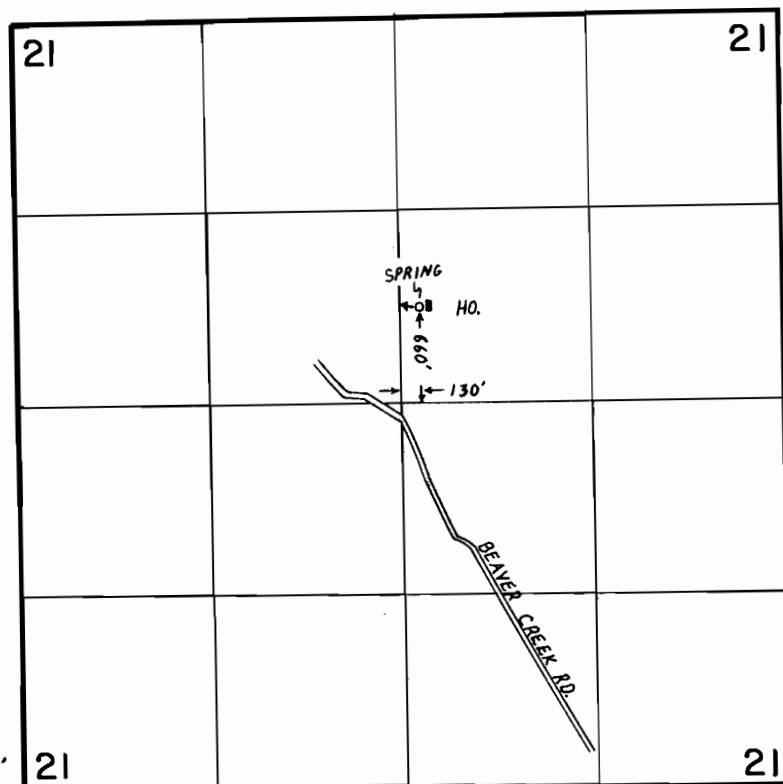

## FINAL PROOF SURVEY UNDER

Application No. 67449. Permit No. 48090....  
IN NAME OF

DANIEL L. & BECKY L. WILSON

Surveyed MAY 25, 1988, by T.M. WARREN.