


T. 23 & 24 S., R. 45 E., W.M.

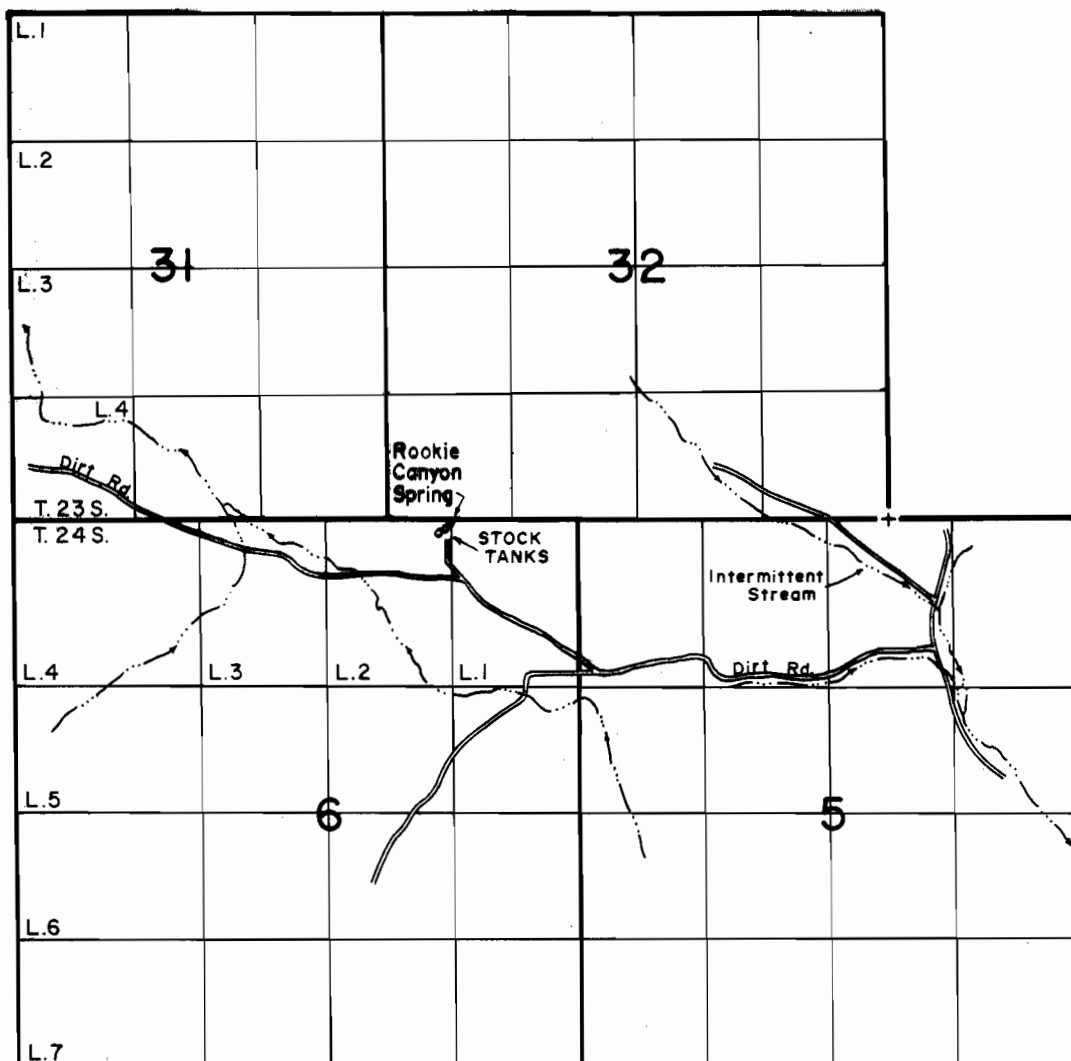

SPRING LOC.: 30' S. & 430' E. FROM THE SW CORNER SECTION 32, T. 23 S., R. 45 E., W.M.

SCALE: 1" = 2000'

## FINAL PROOF SURVEY UNDER

Application No. 67537... Permit No. 48749...  
IN NAME OF

.....DUNCAN D. MACKENZIE.....

Surveyed MAY 10, 1985, by L. M. TOLL.....

3-7-90

THE ELBOW & OWYHEE RIDGE QUAD.