




T. 41 S., R. 13 W., W.M.

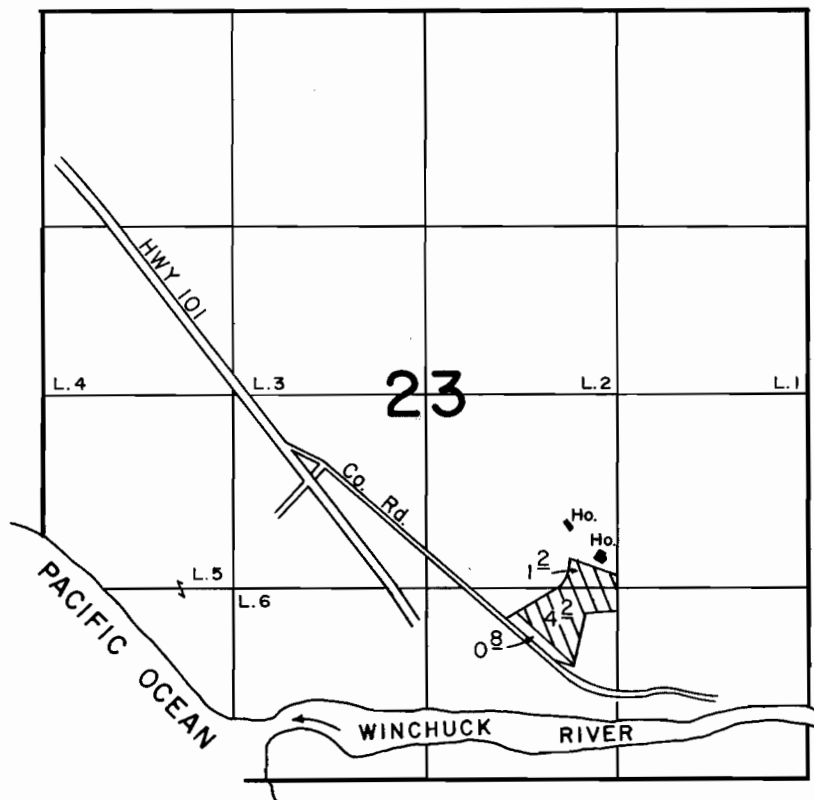

SCALE: 1" = 1320'

FINAL PROOF SURVEY
UNDER

Application No. 68148 Permit No. 48994

IN NAME OF

JACK S. DICHTER

Surveyed APRIL 29 1989, by B. S. JAMES