




# T.7S., R.39E., W.M.

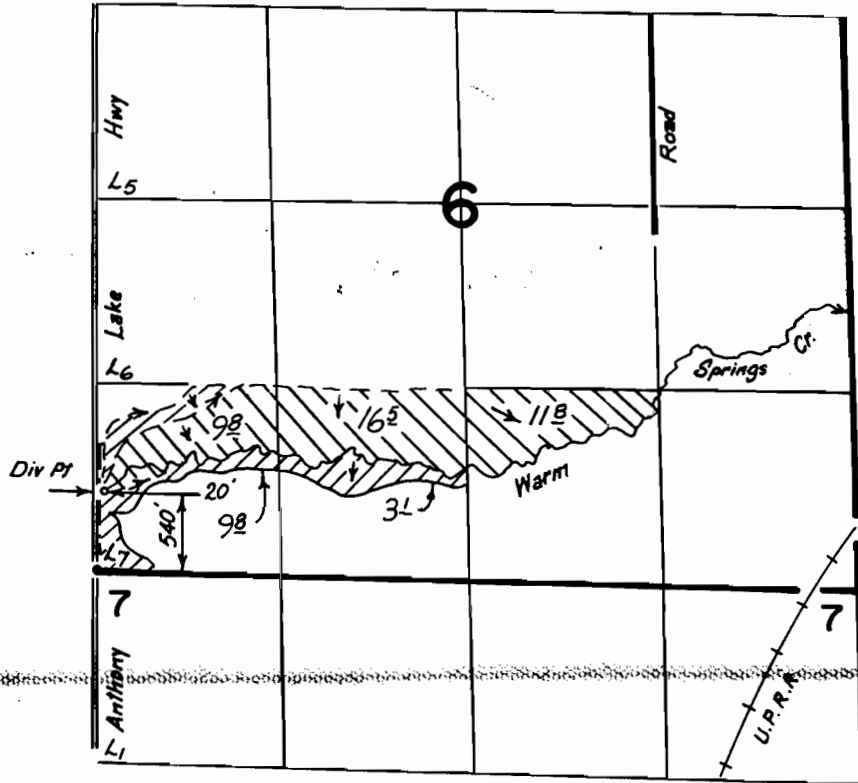

## T.7S., R.38E., W.M.

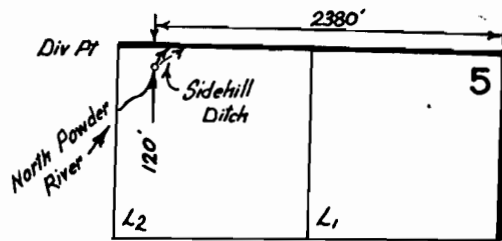

### FINAL PROOF SURVEY UNDER

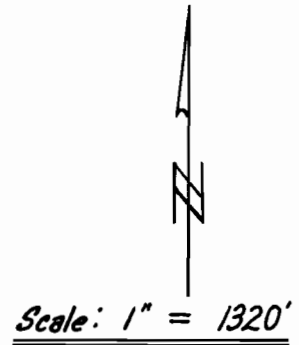

Application No. 68247 Permit No. 49340  
69220 IN NAME OF 50160  
PETER W. SCHOENINGH, JR.  
 Surveyed 4-3 1989, by Kenn Kemp



Primary Irrigation  
(P# 49340) and  
Supplemental Irrigation  
(P# 50160)



Primary Irrigation  
(P# 49340)