

49977


66062

PLANNING

LEO RUPP

WATER RESOURCES DEPT.

THIS RITE

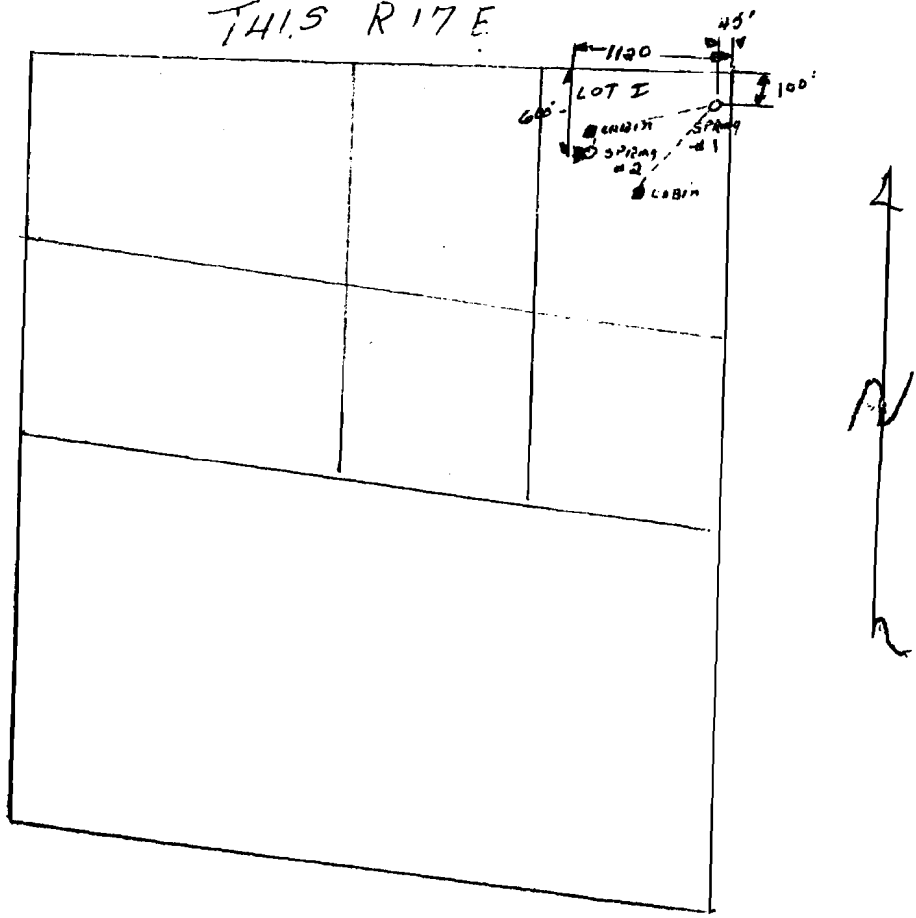

Scale -- 4" = 1m

applicant John Bacon via H. Albertson

Application No. 68708
Permit No. 49977