


T. 7S., R. 3W., W.M.

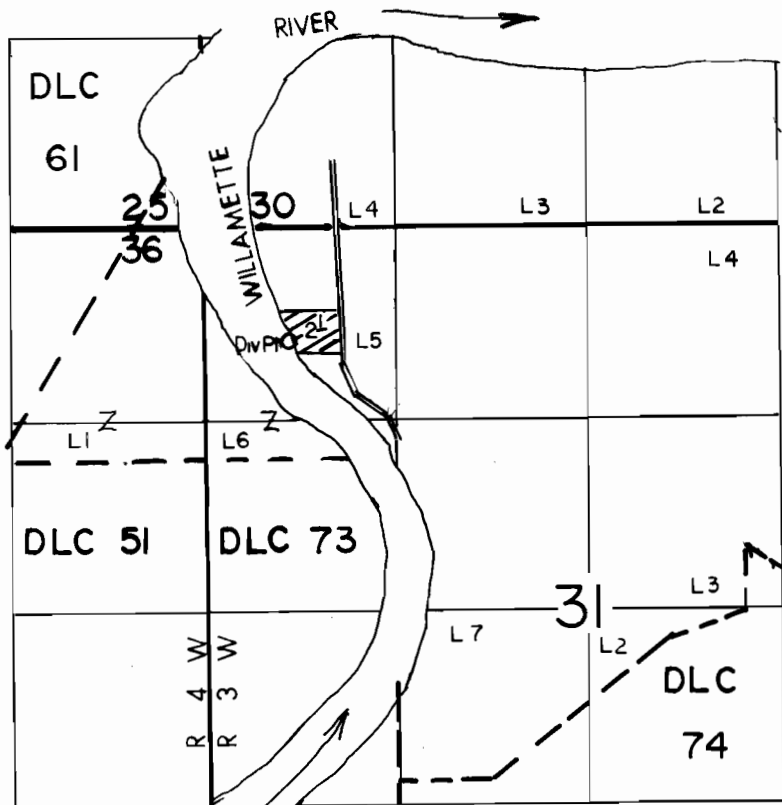

DIV PT LOC 750' S & 600' E FROM THE NW CORNER OF SEC 31

**FINAL PROOF SURVEY**  
UNDER

Application No. 69121..... Permit No. 50072.....

IN NAME OF  
**DORIS NOFZIGER HOWE**  
**GEORGE HUTMACHER**

Surveyed AUG...25.. 1989., by R.W. KLASSEN.....