


# Township 8 South, Range 4 West, W.M.



SE 1/4 SW 1/4, Sec. 12

NE 1/4 NW 1/4, Sec. 13

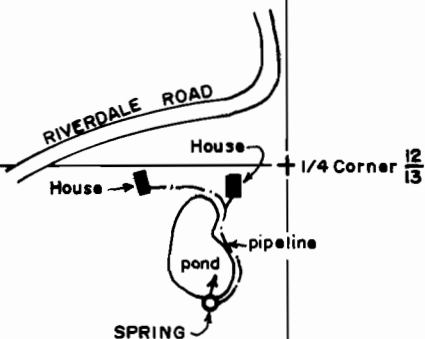

SPRING LOCATED:  
285 ft. South and  
180 ft. West from  
North 1/4 cor. Sec. 13

## FINAL PROOF SURVEY


under

Appl. No. 69234, Per. No. 50135

in names of

LOENE C. BRONSON

RANDY & MARIE BARKER

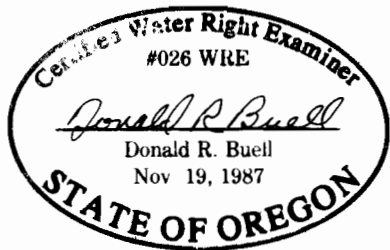

THIS MAP WAS PREPARED FOR THE PURPOSE OF IDENTIFYING THE LOCATION OF A WATER RIGHT ONLY AND IS NOT INTENDED TO PROVIDE LEGAL DIMENSIONS OR LOCATION OF PROPERTY OWNERSHIP LINES.