



T.33S., R.1W., W.M.

DEC 21 1990

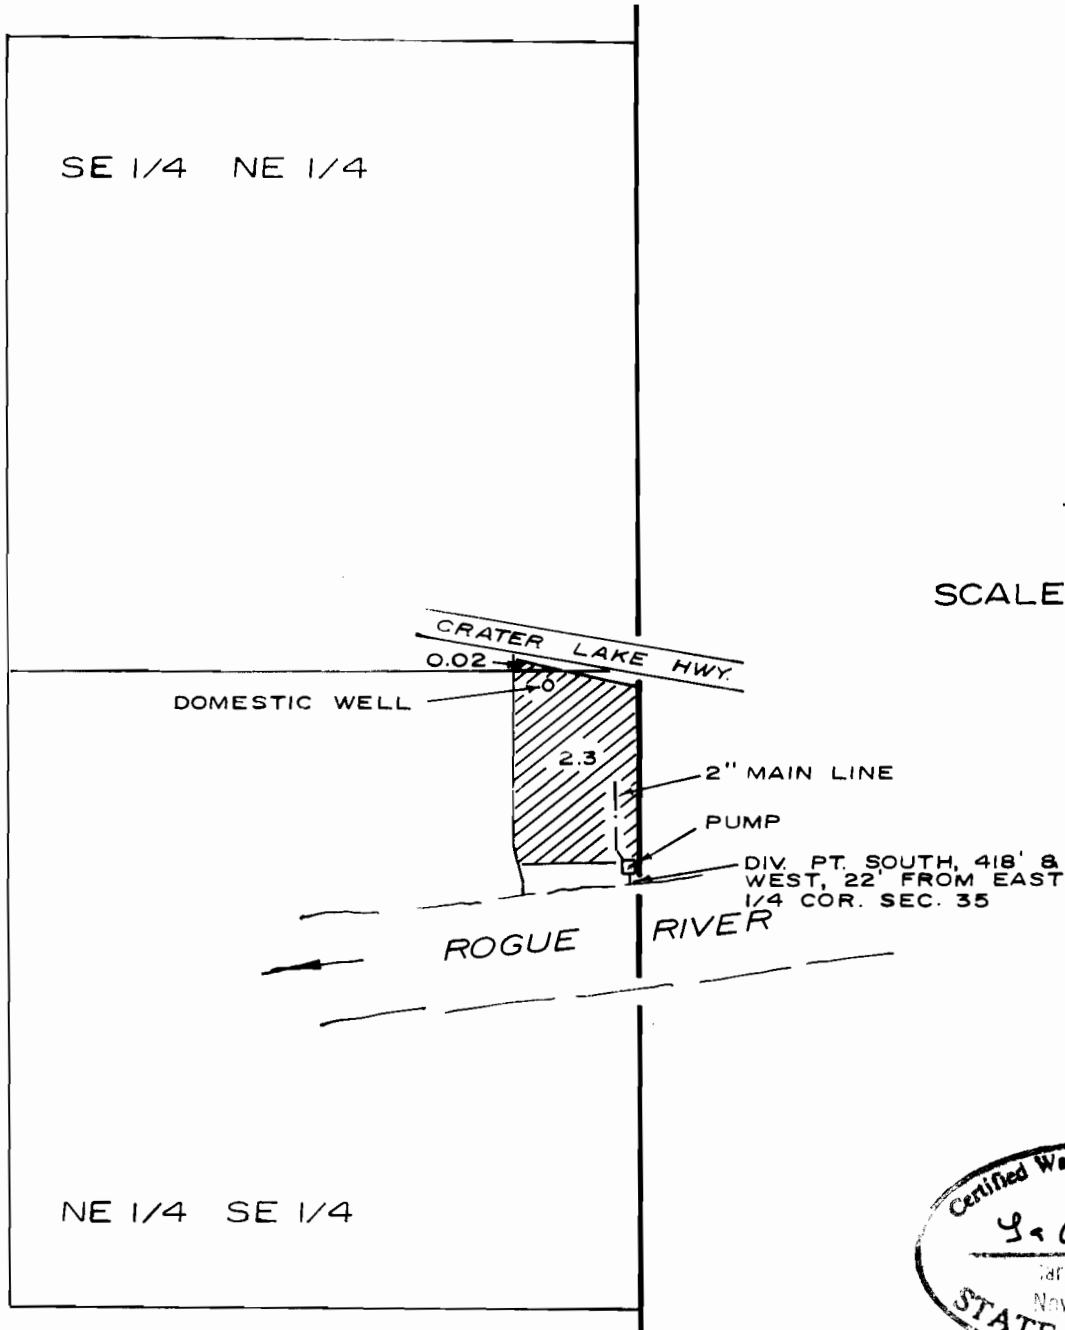

SCALE: 1" = 400'

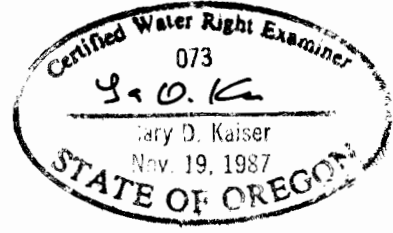

FINAL PROOF MAP

APPLICATION No. 69726 PERMIT No. 50426

NOTE THIS MAP HAS BEEN PREPARED FOR WATER RIGHT PURPOSES ONLY, NOT FOR PROPERTY BOUNDARY LOCATIONS

IN THE NAME OF
JOHN UTLEY

MAP PREPARED AUGUST 24, 1990 BY GARY D. KAISER