


FINAL PROOF SURVEY MAP

IN THE NAME OF LARRY H. JOHNSON
 APPLICATION 69855 PERMIT 50723
 SECTION 23, T26S, R6W, W.M.
 LOT 30, RIVER BEND ACRES SUBDIVISION, PLAT A

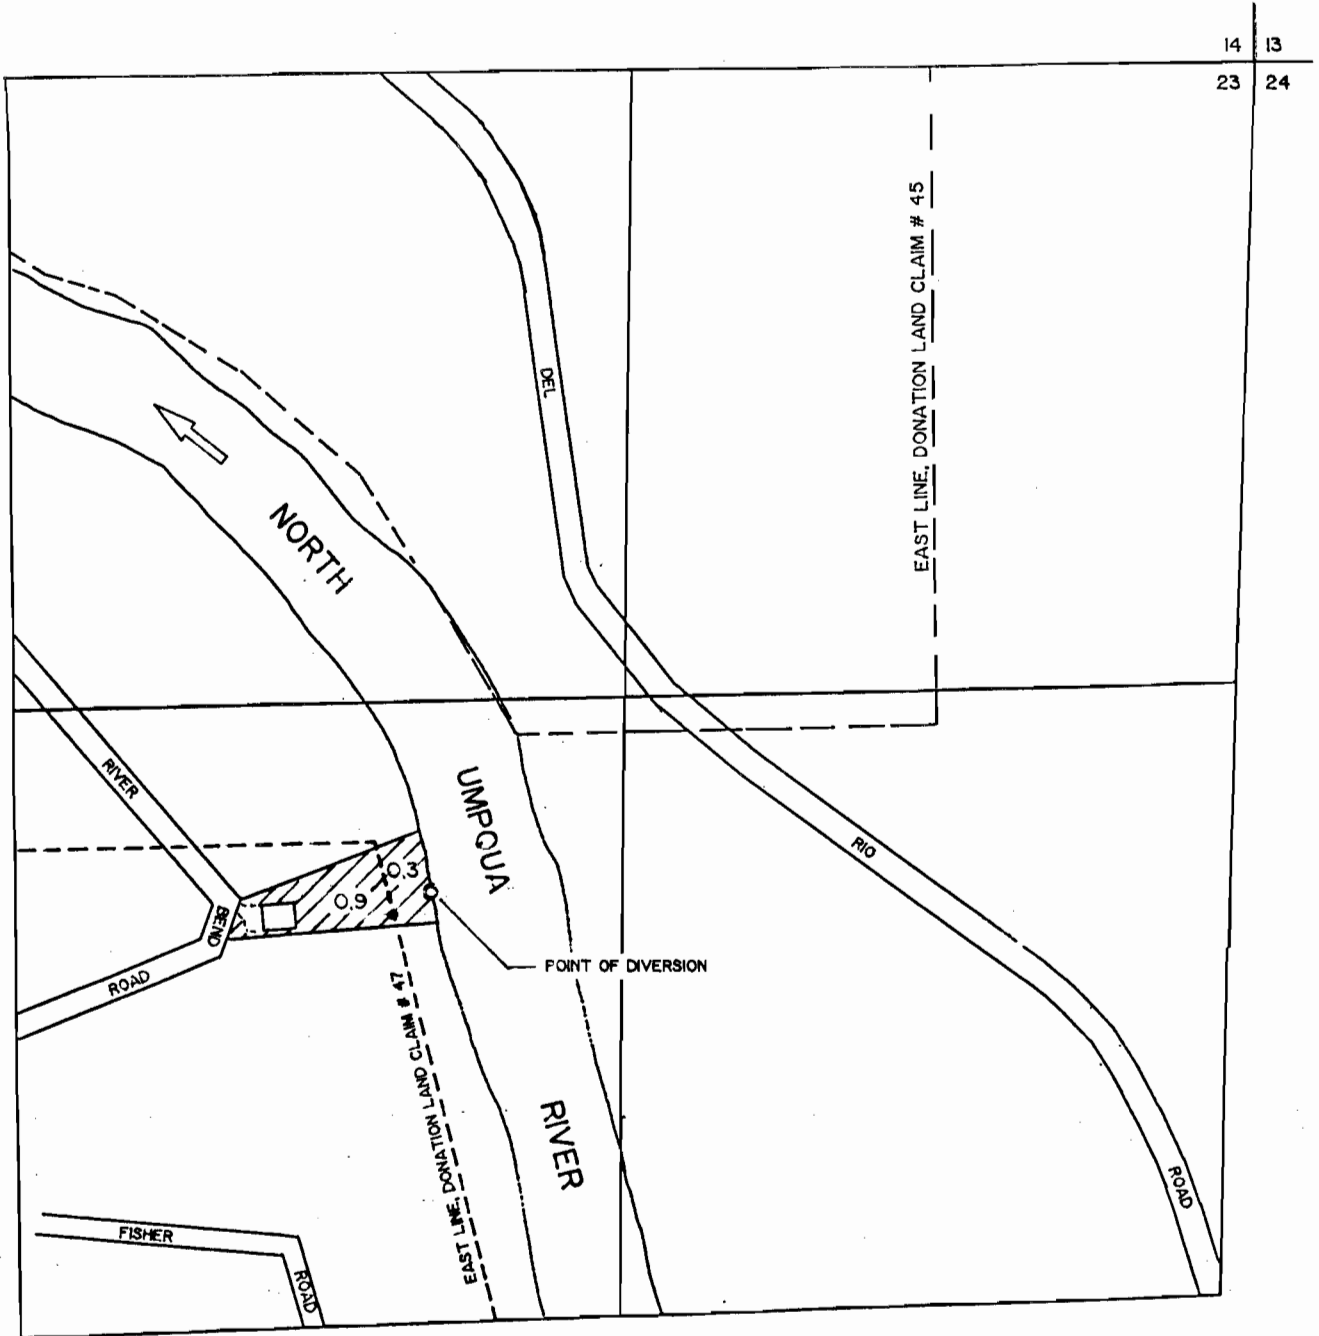

SCALE: 1 INCH = 400 FEET



THE POINT OF DIVERSION IS LOCATED 1810 FEET SOUTH AND 1680 FEET WEST FROM THE NORTHEAST CORNER OF SECTION 23, BEING WITHIN THE SW 1/4 OF THE NE 1/4 SECTION 23, TOWNSHIP 26 SOUTH, RANGE 6 WEST, W.M., DOUGLAS COUNTY.

THE PURPOSE OF THIS MAP IS TO IDENTIFY THE LOCATION OF THE WATER RIGHT. IT IS NOT INTENDED TO PROVIDE INFORMATION RELATIVE TO THE LOCATION OF PROPERTY OWNERSHIP BOUNDARY LINES.

