
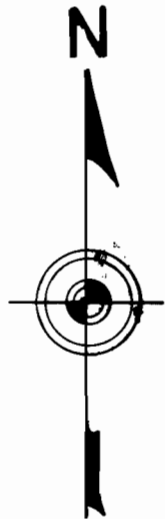


T.28S. R.14W.W.M.

1" = 400'

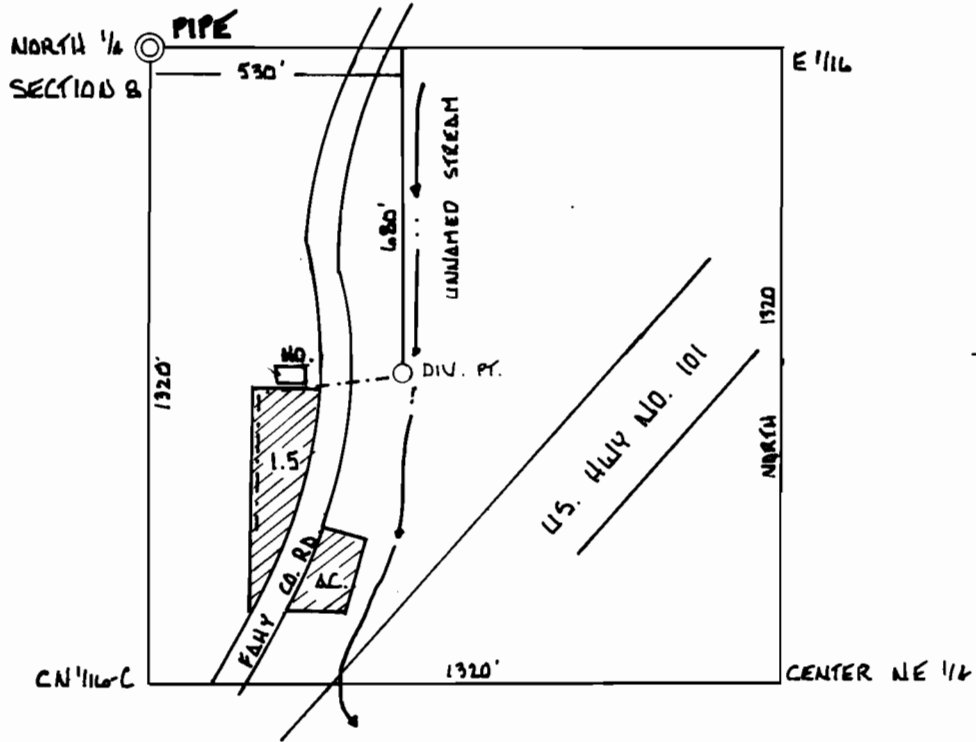

FINAL PROOF SURVEY

UNDER PERMIT NO: 50701 APPLICATION NO 69873.

IN THE NAME OF:

JACK HOLTON.

DATE: OCT. 10, 1990

SURVEYED BY: JOHN P. PRAHAR C.W.R.E. # 107