


T.19S., R.46E., W.M.

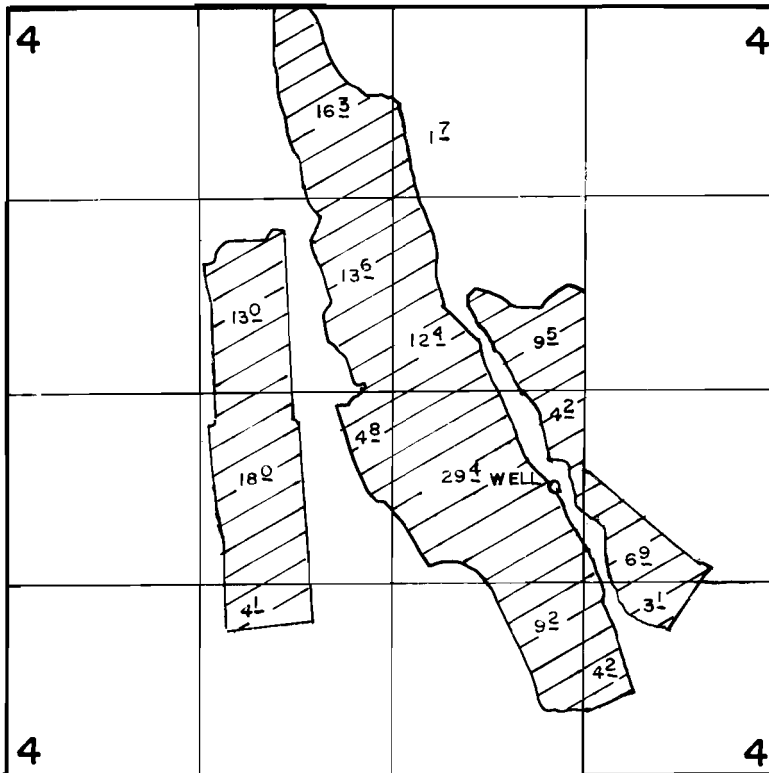

Well Located 1950' N & 1530' W From The SE Corner Of Section 4

SCALE: 1" = 1320'

FINAL PROOF SURVEY
UNDER

Application No. G-8501.. Permit No. G-7663.....
IN NAME OF

.....**ROGER FINDLEY**.....

Surveyed **MARCH 28 1986..** by **J.M. TOLL**.....