


T. 38 S., R. 1 E., W. M.

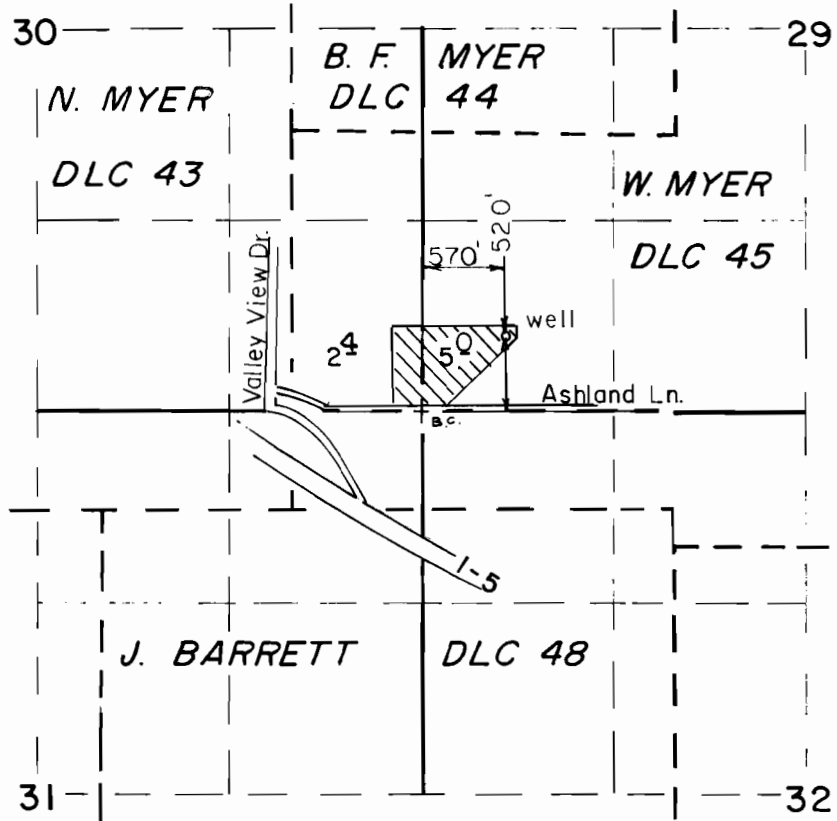

Scale: 1" = 1320'

FINAL PROOF SURVEY UNDER

Application No. G-8948. Permit No. G-10549.
IN NAME OF

..... ELIZABETH T. ROBINSON

Surveyed DEC. 6. 19.90, by B. S. JAMES.....