


# T.5S., R.2W., W.M.

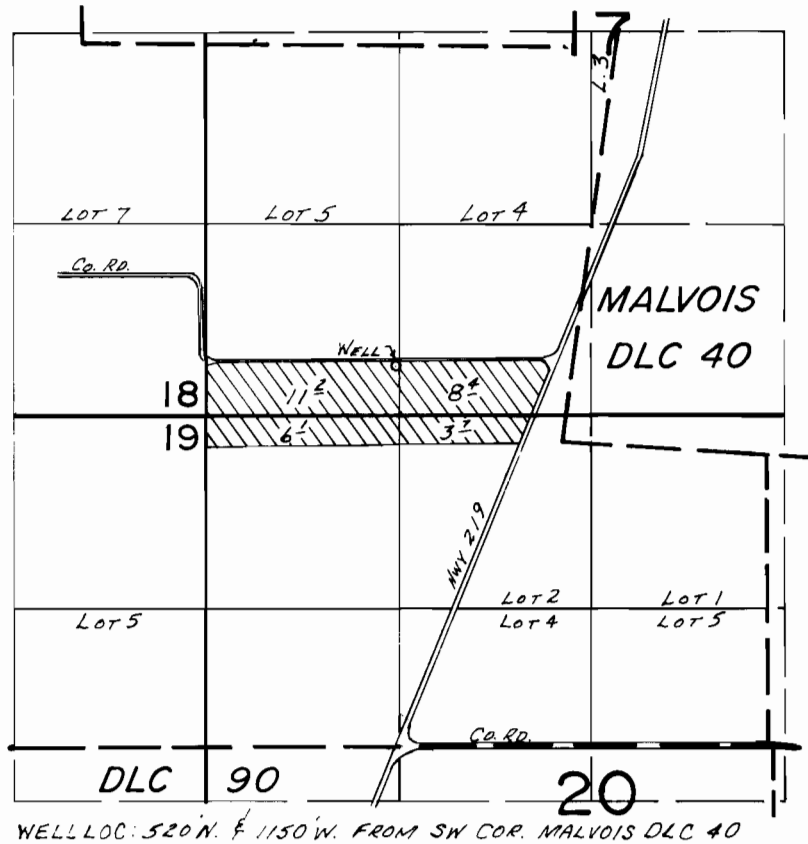

## FINAL PROOF SURVEY UNDER

Application No. G-10165 Permit No. G-9628.....

IN NAME OF

SCOTT MILLER

Surveyed Sept. 27.. 19.83, by L.M.TOLL.....