




T. 38 S., R. 11 1/2 E., W.M.

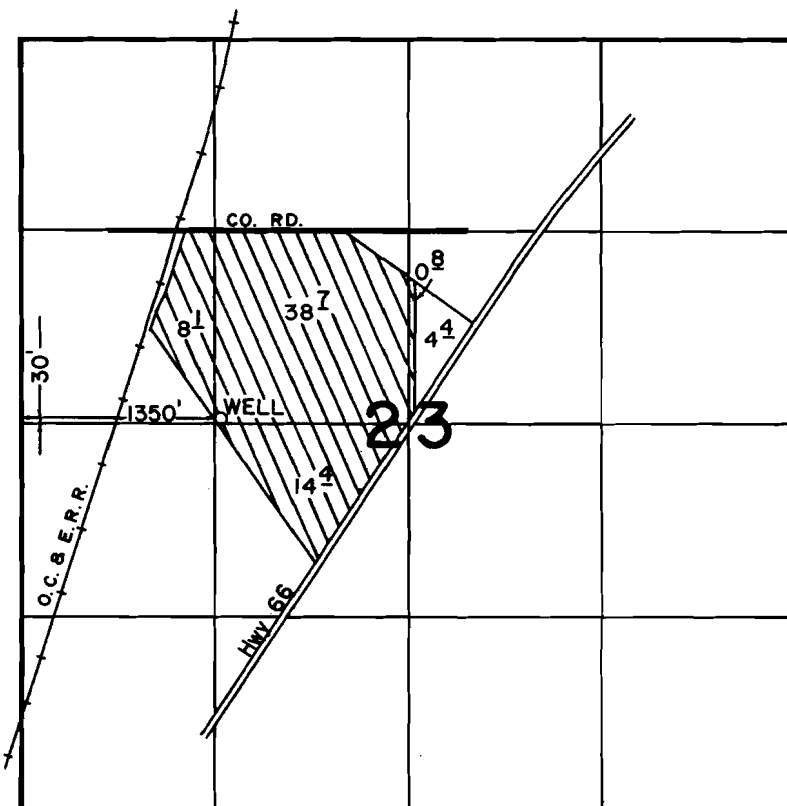

Buck Co. v. James Chas. Schell

SCALE: 1" = 1320'

FINAL PROOF SURVEY UNDER

Application No. G-10768 Permit No. G-10023
IN NAME OF

..... DALE E. LARRICK

Surveyed SEPT. 21, 1989, by B. W. BISHOP.....

gz